

CONTRACT CHANGE ORDERChange Requested by: Engineer Contractor

CCO No.	Suppl. No.	Contract No.	Road	Federal Number(s)
3	0	217245	Alderpoint Road PM 2.10	ER-32L0(268)

To: **Stimpel-Wiebelhaus, Assoc.** Contractor

You are directed to make the following changes from the plans and specifications or do the following described work not included in the plans and specifications for this contract. **NOTE: This change order is not effective until approved by the Engineer**

Description of work to be done, estimate of quantities and prices to be paid. (Segregate between additional work at contract price, agreed price and force account.) Unless otherwise stated, rates for rental of equipment cover only such time as equipment is used and no allowance will be made for idle time. The last percentage shown is the net accumulated increase or decrease from the original quantity in the Engineer's Estimate.

In accordance with Section 4-1.05 "Changes and Extra Work" of the Standard Specifications, replace sheets 6, 8, and 9 of the project plans with the attached plan sheets 6a, 8a-d, and 9a-d. Install 36" OMP and 18" Culvert near Sta 2+30 as directed by the Engineer.

Increase of Bid Items at Bid Item Prices:

- Bid Item 17, "Roadway Excavation" +4,533 CY @ \$25.00/CY = +\$113,325.00
- Bid Item 19, "Structural Excavation" +357 CY @ \$55.00/CY = +\$19,635.00
- Bid Item 20, "Embankment" +259 CY @ \$29.00/CY = +\$7,511.00
- Bid Item 23, "Dry Seed" +13,752 SQFT @ \$0.15/SQFT = +\$2,062.80
- Bid Item 25, "Straw" +13,752 SQFT @ \$0.15/SQFT = +\$2,062.80
- Bid Item 26, "Class II Aggregate Base" +27.93 CY @ \$120.00/CY = +\$3,351.60
- Bid Item 27, "Hot Mix Asphalt (Type A)" +103.23 Tons @ \$250.00/Ton = +\$25,807.50
- Bid Item 32, "18" Corrugated Steel Pipe (0.109" Thick)" +56 LF @290/LF = +\$16,240.00
- Bid Item 38, "36" Corrugated Steel Pipe Inlet (0.109" Thick)" +4 LF @ \$1,200.00/LF = +\$4,800.00
- Bid Item 44, "RSP (150 LB Class III, Method B) +1 CY @ \$210.00/CY = +\$210.00
- Bid Item 45, "RSP (60 LB Class II, Method B) +1 CY @ \$1,000.00/CY = +\$1,000.00

Total Increase of Bid Items at Bid Item Prices = \$196,005.70**Decrease of Bid Items at Bid Item Prices:**

- Bid Item 43, "RSP (1 Ton Class VIII, Method A)" (49.00 CY) @ \$155.00/CY = (\$7,595.00)

Total Decrease = (\$7,595.00)**Extra Work at Agreed Lump Sum:**

- Provide personnel to monitor the slide activity
- Provide additional traffic control
- Install trench drain
- Locate utilities
- Remove RSP placed to mitigate slide activity

For this work, the contractor shall receive and accept a lump sum of \$157,834.51. This sum constitutes full and complete compensation for furnishing all labor, material, equipment, tools, and incidentals including all markups by reason of this change.

Total Extra Work at Agreed Lump Sum = \$157,834.51

HUMBOLDT COUNTY DEPARTMENT OF PUBLIC WORKS

Sheet 2 of 11**CONTRACT CHANGE ORDER**Change Requested by: Engineer Contractor

CCO No.	Suppl. No.	Contract No.	Road	Federal Number(s)
3	0	217245	Alderpoint Road PM 2.10	ER-32L0(268)



Time Adjustment:

A determination of the delay in completion of the contract due to the work specified by this change has been made in accordance with the provisions of Section 8-1.07, "Delays," of the Standard Specifications.


The work ordered by this change affected the contract completion date due to work performed from 7/22/2024 to 08/05/2024 (11 days) and from 10/18/2024 to 10/24/2024 (5 days). The contractor shall be granted a total of sixteen (16) days for delay caused by this change.

Estimated Cost: Decrease Increase \$346,245.21

By reason of this order the time of completion will be adjusted as follows: **SIXTEEN (16) WORKING DAY EXTENSION**

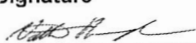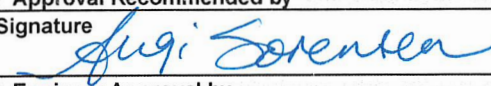Submitted by		
Signature	(Print name & title)	Date
	Nathan Hayler, P.E., Resident Engineer	2/19/2025
Approval Recommended by		
Signature	(Print name & title)	Date
	Angi Sorensen, P.E., Assoc. Civil Engineer	2/25/25
Engineer Approval by		
Signature	(Print name & title)	Date
	Thomas K. Mattson, P.E., Director of Public Works	

We the undersigned contractor, have given careful consideration to the change proposed and agree, if this proposal is approved, that we will provide all equipment, furnish the materials, except as may otherwise be noted above, and perform all services necessary for the work above specified, and will accept as full payment therefor the prices shown above. **NOTE: If you, the contractor, do not sign acceptance of this order, your attention is directed to the requirements of the specification as to proceeding with the ordered work and filing a written protest within the time therein specified.**

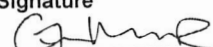
Contractor Acceptance by		
Signature	(Print name & title)	Date
	Garrett Miller, Project Manager	02/25/25

- NOTE:
- UNDERGROUND UTILITIES EXIST IN PROJECT VICINITY. CONTACT U.S.A. PRIOR TO ANY AND ALL EXCAVATION.
 - SEE SHEET 2 FOR ALIGNMENT DATA

ROAD NAME: ALDERPOINT ROAD	DESIGN SECTION
ROAD NO: 68165	ENGINEERING
PROJECT NO.: ER-3210(268)	DESIGNED BY: RMD
CONTRACT NO.: 217245	DRAWN BY: RMD
DRAWING FILE NAME: 217245 ALD 2.1	REVIEWED BY: JAB
PLOT DATE: 06/27/2024	APPROVED BY: TRS
MILE POST: 2.10	REVISION DATE:


COUNTY OF HUMBOLDT DEPARTMENT OF PUBLIC WORKS STORM DAMAGE REPAIR TO ALDERPOINT ROAD PM 2.10 ALDERPOINT ROAD PLAN AND PROFILE - REVISED	SHEET
	6a
	OF
	42

CO 3 Sheet 3 of 11 Attachment 1

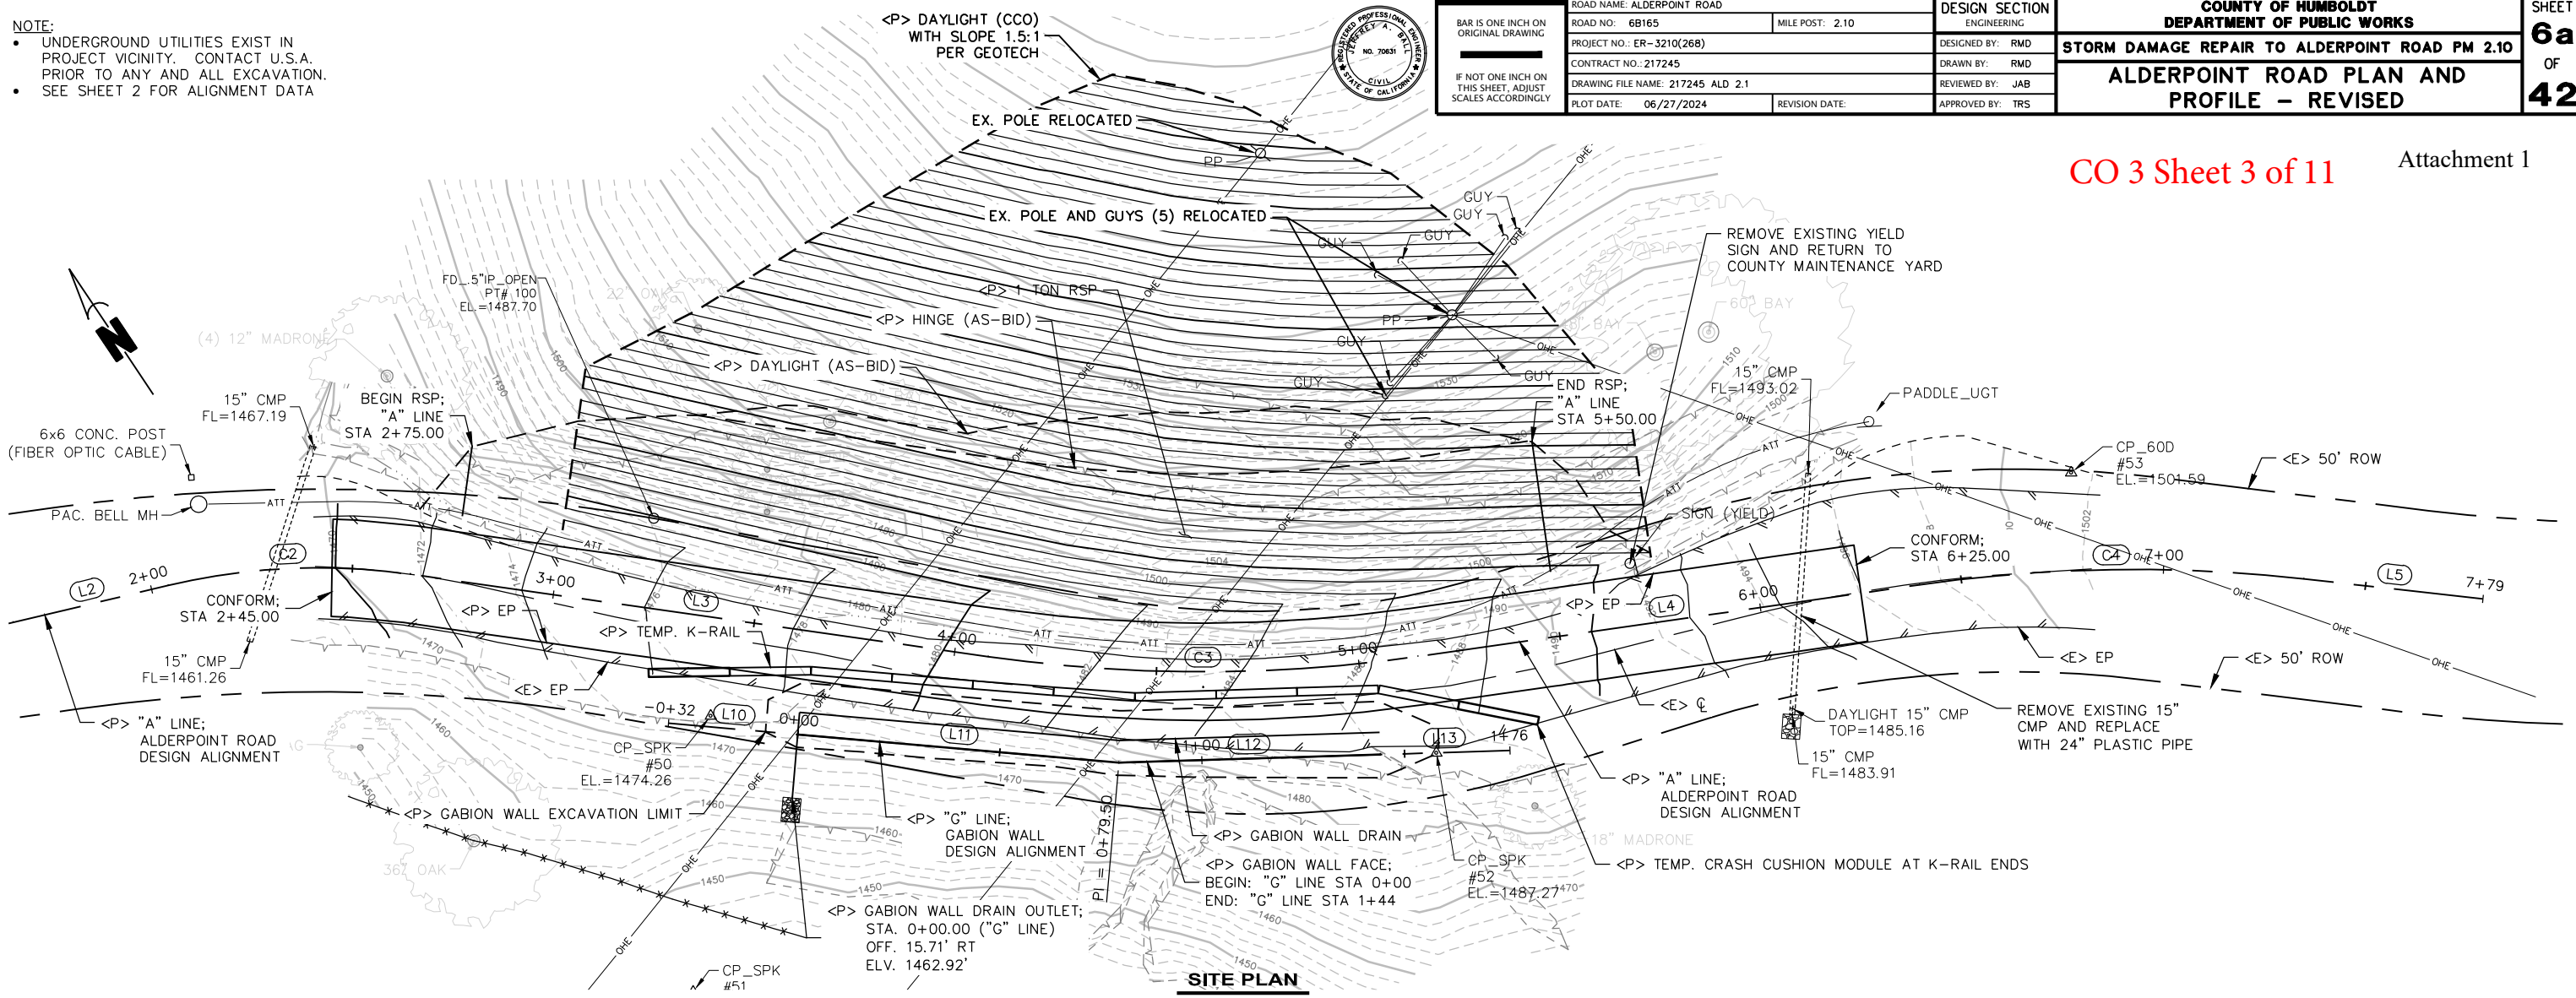

SITE PLAN
SCALE: 1"=20'

'A' LINE Alignment PROFILE
Station

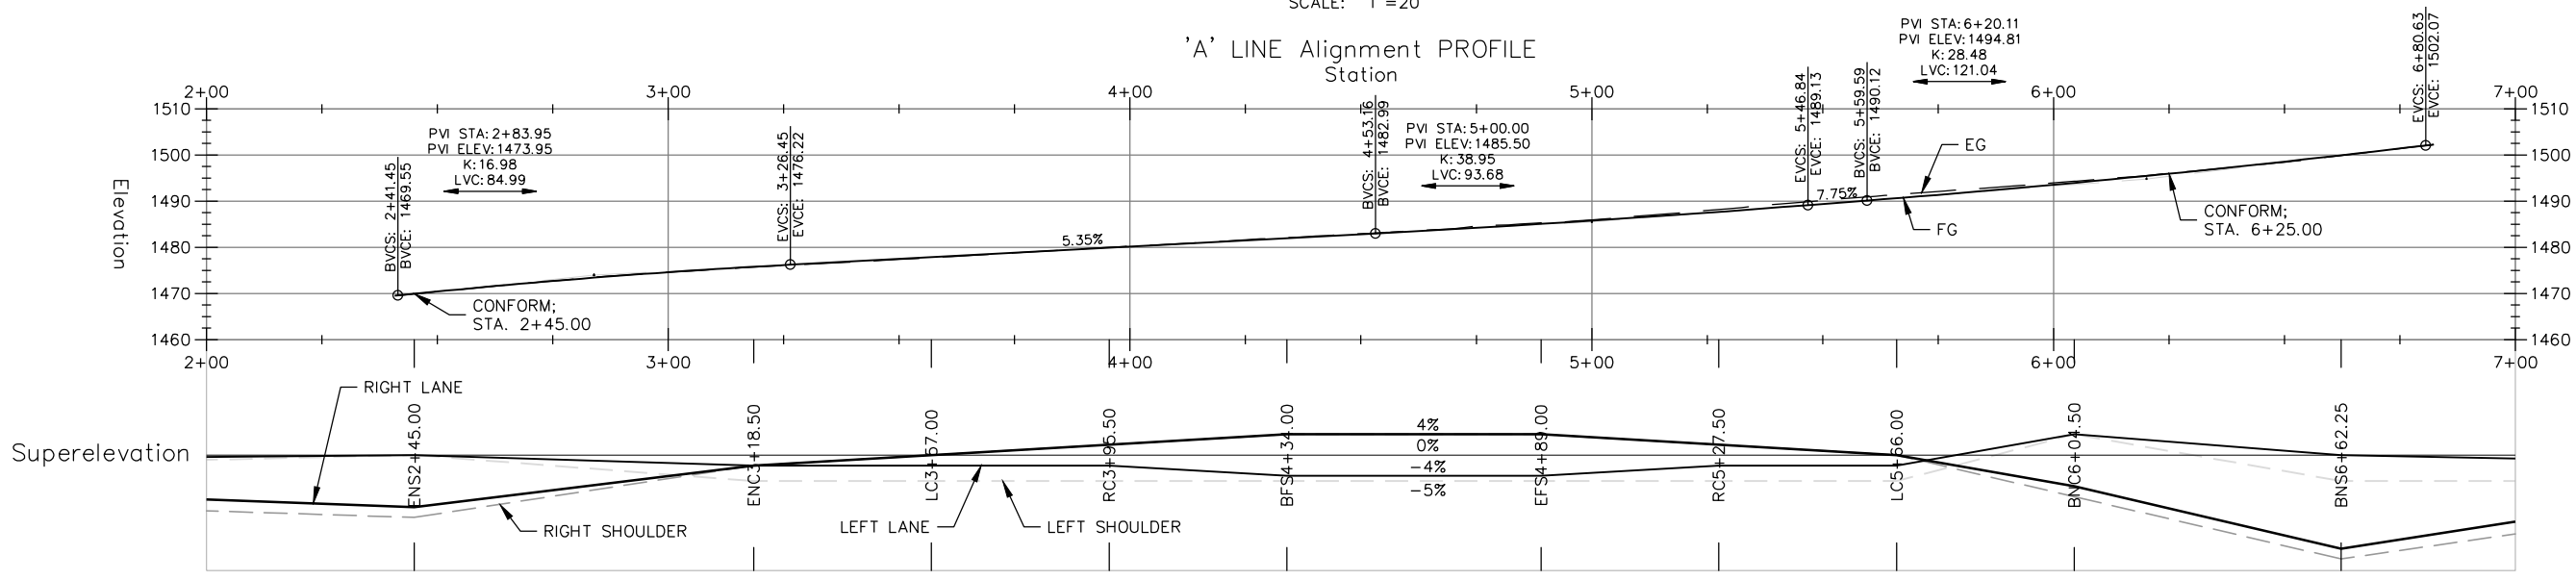

SUPERELEVATION & PROFILE VIEW






SCALE: 1"=20'(H,V)



BAR IS ONE INCH ON ORIGINAL DRAWING	ROAD NAME: ALDERPOINT ROAD	DESIGN SECTION
IF NOT ONE INCH ON THIS SHEET, ADJUST SCALES ACCORDINGLY	ROAD NO.: 68165	ENGINEERING
	PROJECT NO.: ER-3210(268)	DESIGNED BY: RMD
	CONTRACT NO.: 217245	DRAWN BY: RMD
	DRAWING FILE NAME: 217245 ALD 2.1	REVIEWED BY: JAB
	PLOT DATE: 06/27/2024	APPROVED BY: TRS
	REVISION DATE:	

COUNTY OF HUMBOLDT DEPARTMENT OF PUBLIC WORKS		SHEET
STORM DAMAGE REPAIR TO ALDERPOINT ROAD PM 2.10		8a
ALDERPOINT ROAD SECTIONS		OF
		42

CO 3 Sheet 4 of 11 Attachment 1

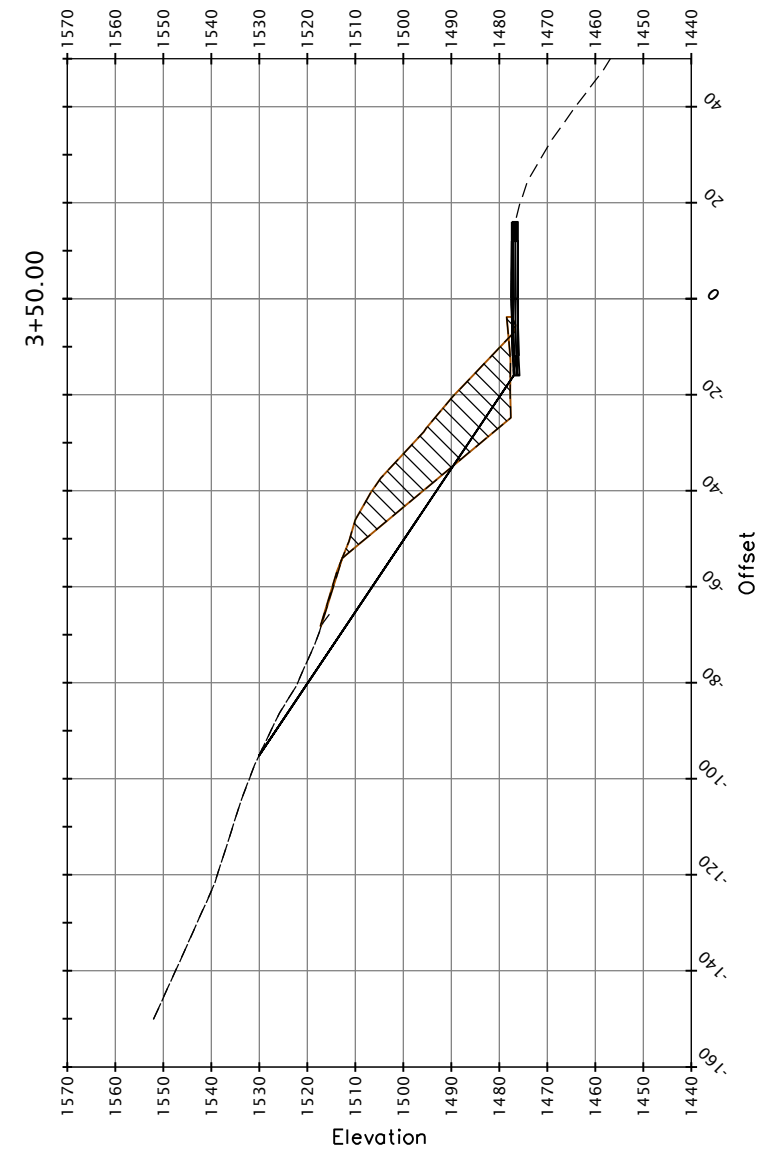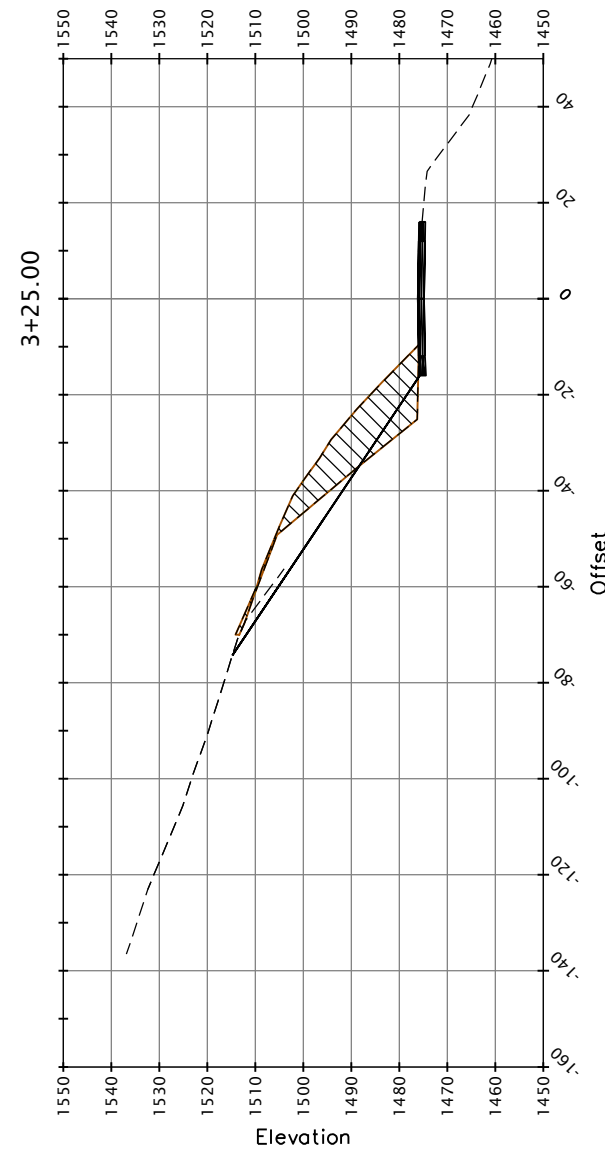
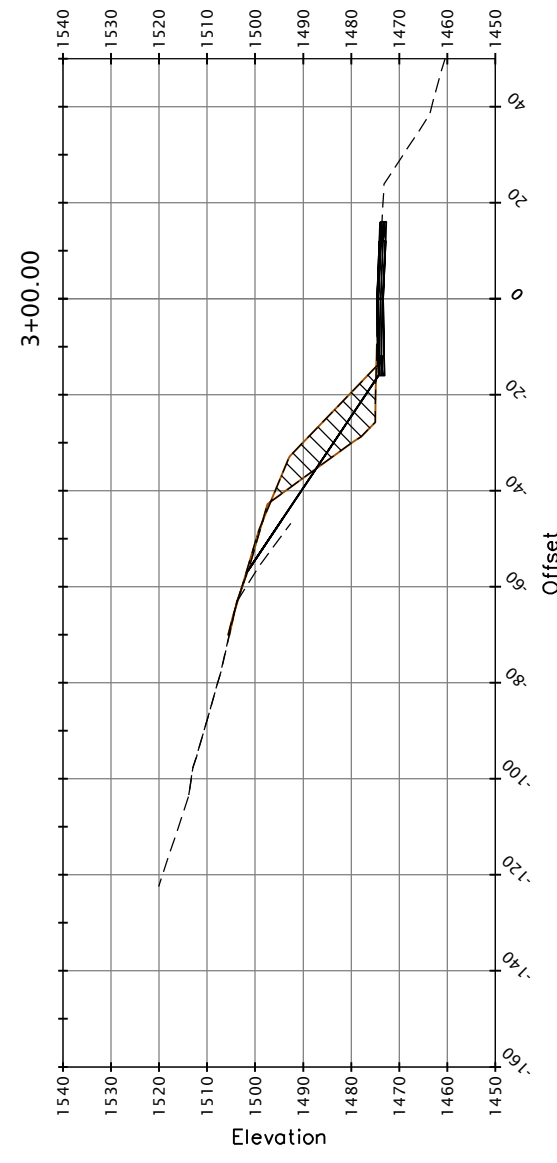
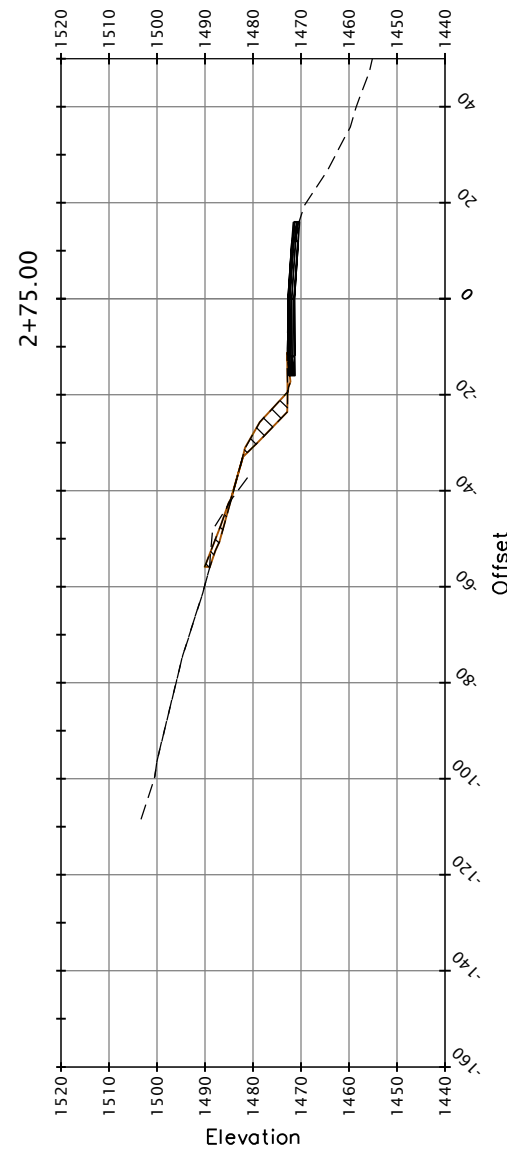
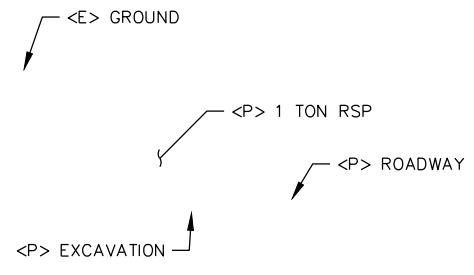


SECTION VIEWS
SCALE: 1" = 20'



ROAD NAME: ALDERPOINT ROAD		DESIGN SECTION	COUNTY OF HUMBOLDT DEPARTMENT OF PUBLIC WORKS	SHEET 8b OF 42
ROAD NO.: 68165	MILE POST: 2.10	ENGINEERING		
PROJECT NO.: ER-3210(268)		DESIGNED BY: RMD	STORM DAMAGE REPAIR TO ALDERPOINT ROAD PM 2.10	
CONTRACT NO.: 217245		DRAWN BY: RMD	ALDERPOINT ROAD SECTIONS	
DRAWING FILE NAME: 217245_ALD_2.1		REVIEWED BY: JAB		
DATE: 06/27/2024	REVISION DATE:	APPROVED BY: TRS		

CO 3 Sheet 5 of 11 Attachment 1

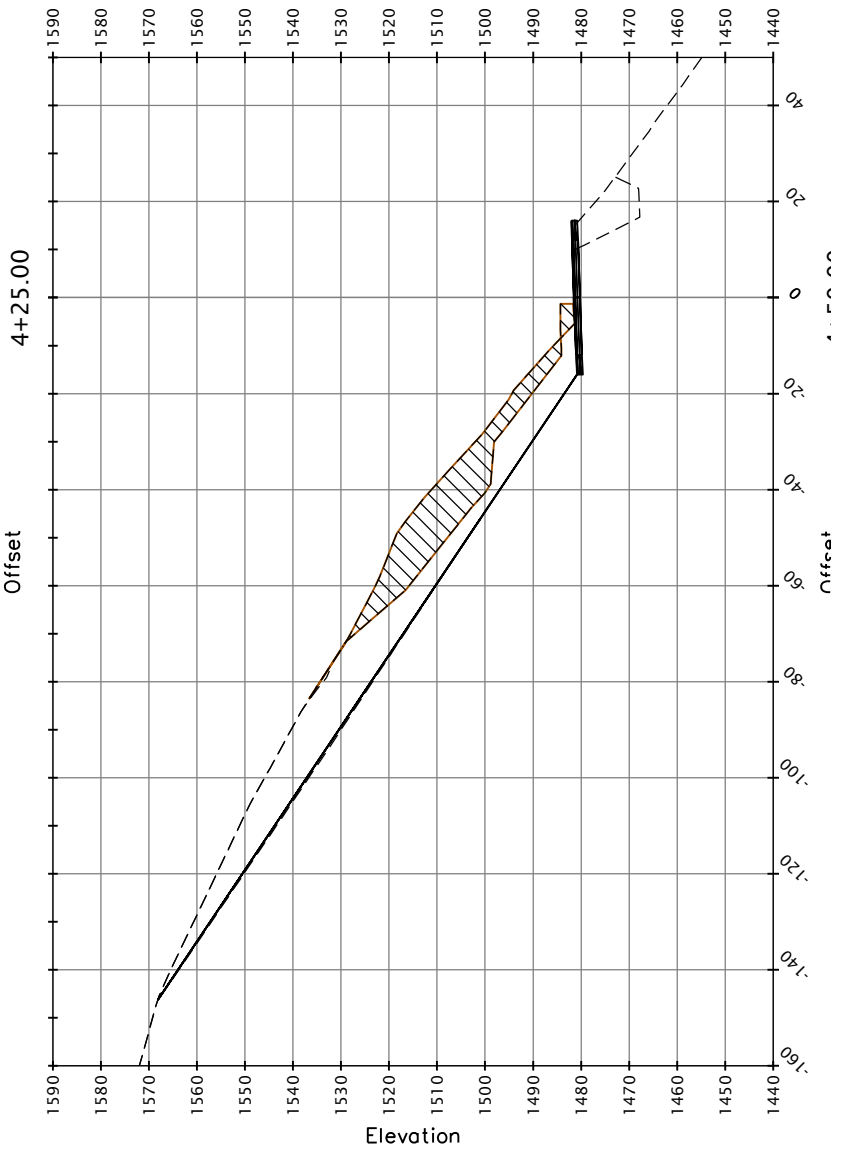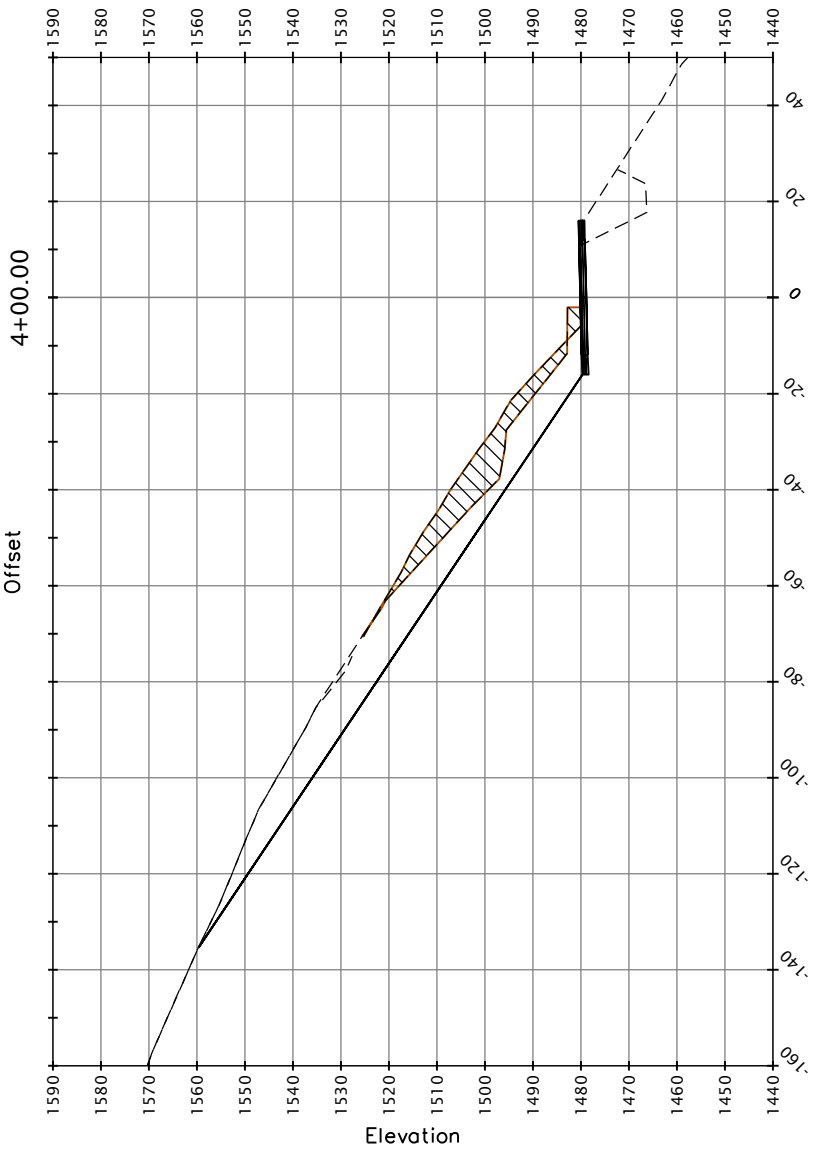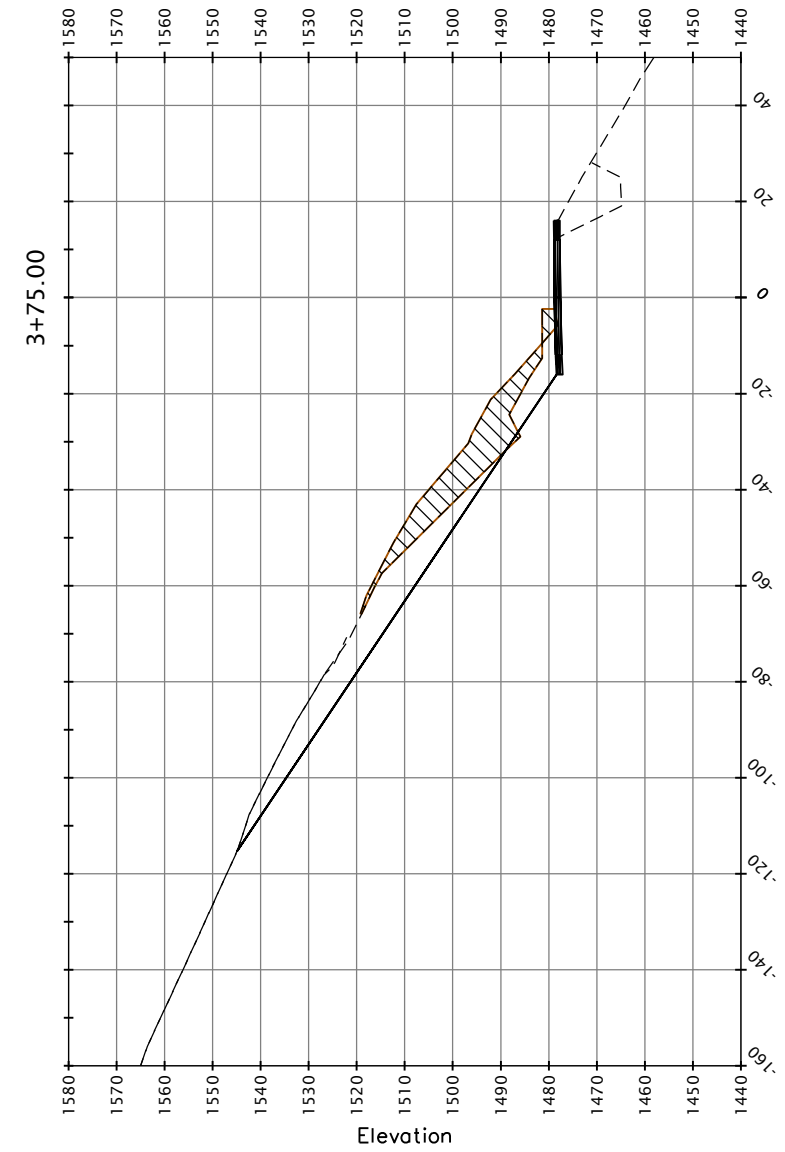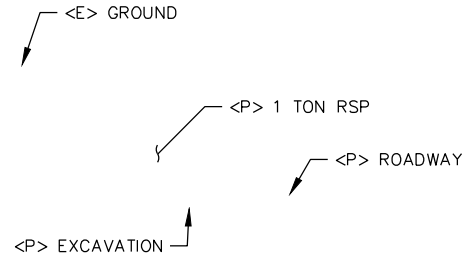

SECTION VIEWS
SCALE: 1" = 20'








ROAD NAME: ALDERPOINT ROAD	MILE POST: 2.10
ROAD NO.: 68165	
PROJECT NO.: ER-3210(268)	
CONTRACT NO.: 217245	
DRAWING FILE NAME: 217245_ALD_2.1	
PLOT DATE: 06/27/2024	REVISION DATE:

DESIGN SECTION
ENGINEERING
DESIGNED BY: RMD
DRAWN BY: RMD
REVIEWED BY: JAB
APPROVED BY: TRS

COUNTY OF HUMBOLDT
DEPARTMENT OF PUBLIC WORKS
STORM DAMAGE REPAIR TO ALDERPOINT ROAD PM 2.10
ALDERPOINT ROAD SECTIONS

SHEET
8c
OF
42

CO 3 Sheet 6 of 11 Attachment 1

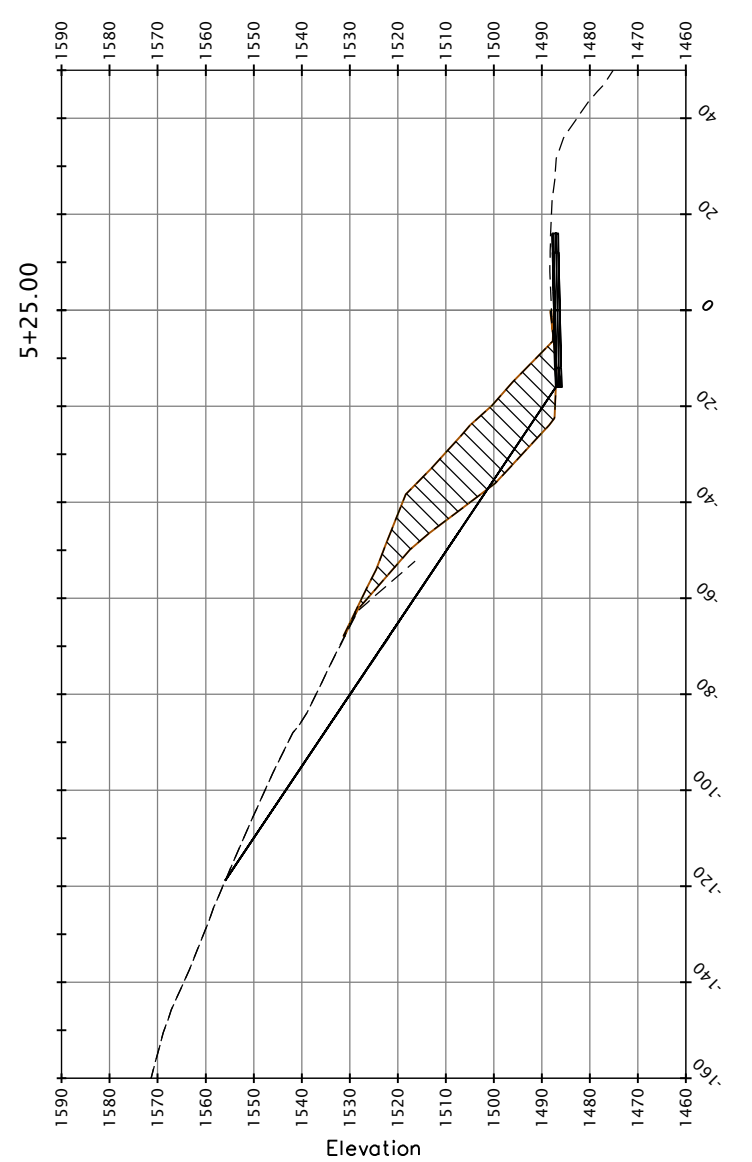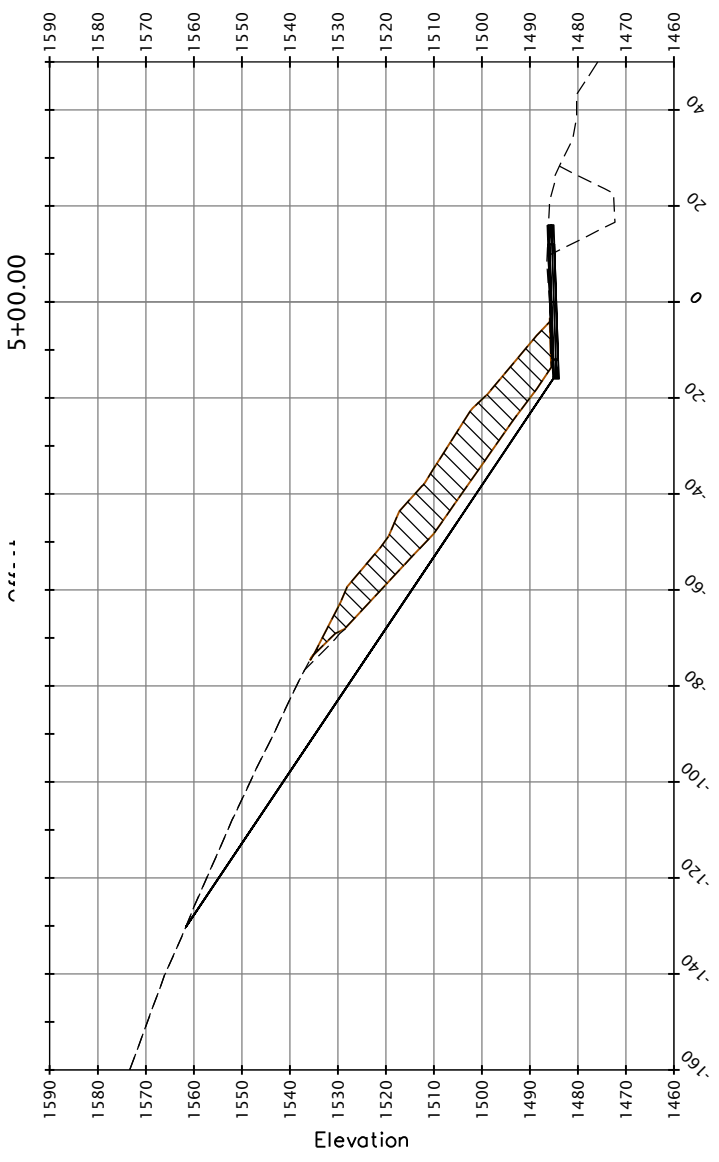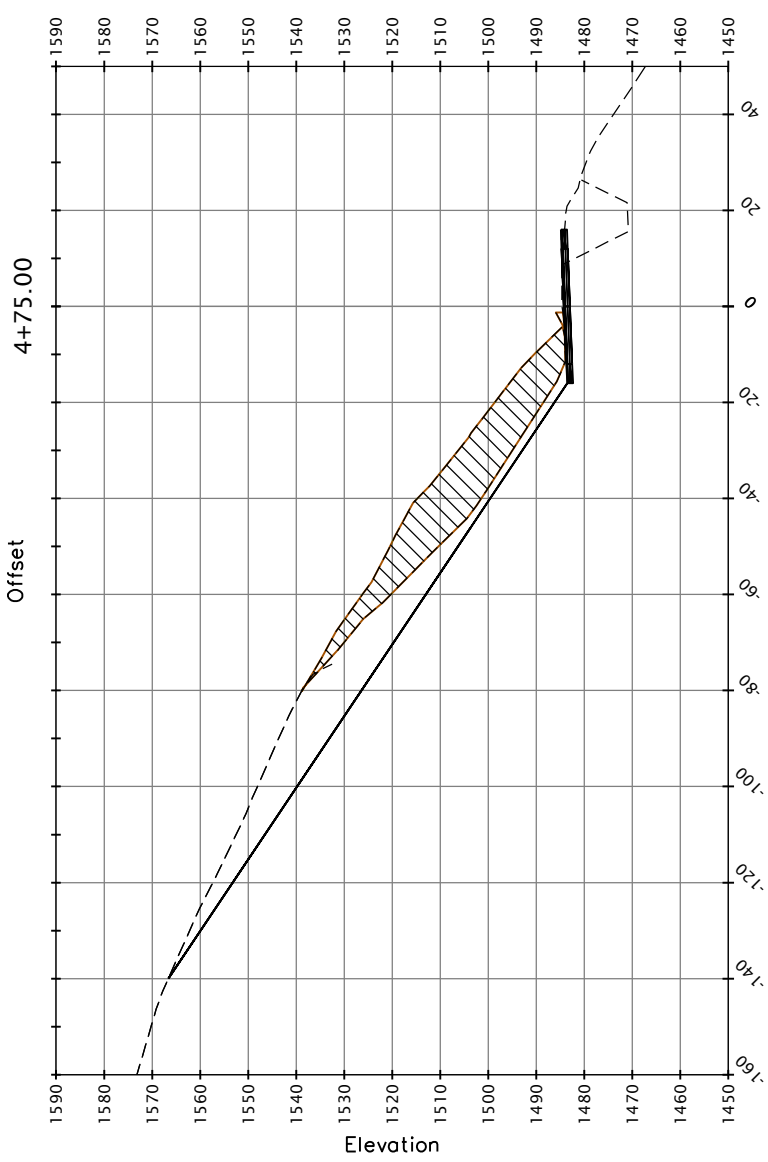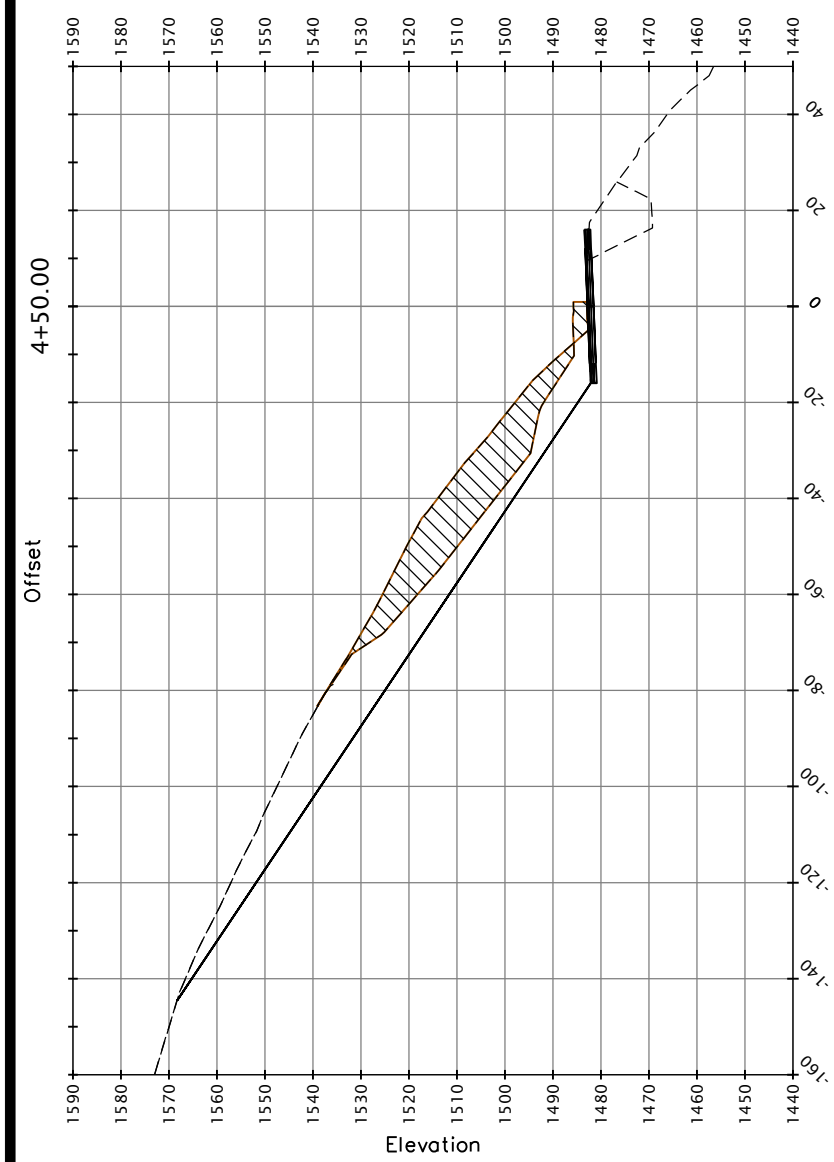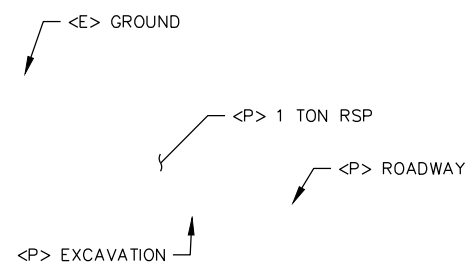

SECTION VIEWS
SCALE: 1" = 20'



BAR IS ONE INCH ON ORIGINAL DRAWING

IF NOT ONE INCH ON THIS SHEET, ADJUST SCALES ACCORDINGLY

ROAD NAME: ALDERPOINT ROAD
 ROAD NO.: 68165
 PROJECT NO.: ER-3210(268)
 CONTRACT NO.: 217245
 DRAWING FILE NAME: 217245_ALD_2.1
 PLOT DATE: 06/27/2024

MILE POST: 2.10

DESIGN SECTION
 ENGINEERING

DESIGNED BY: RMD
 DRAWN BY: RMD
 REVIEWED BY: JAB
 APPROVED BY: TRS

COUNTY OF HUMBOLDT
 DEPARTMENT OF PUBLIC WORKS

STORM DAMAGE REPAIR TO ALDERPOINT ROAD PM 2.10

ALDERPOINT ROAD SECTIONS




SHEET
8d
 OF
42

CO 3 Sheet 7 of 11 Attachment 1

<P> EXCAVATION

<P> 1 TON RSP

<P> ROADWAY

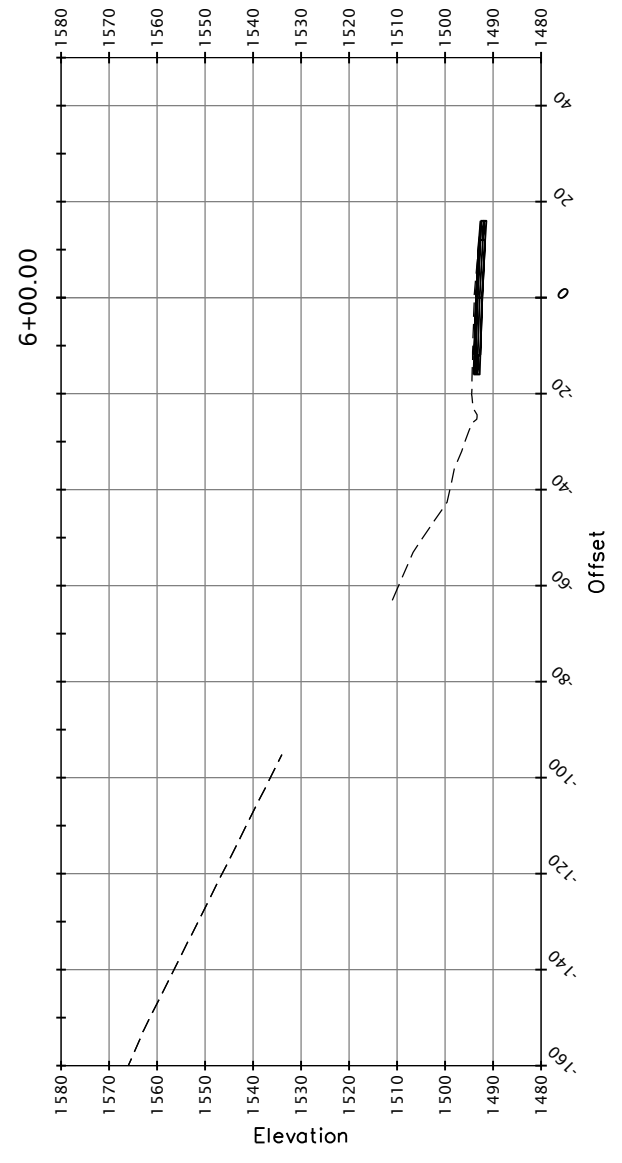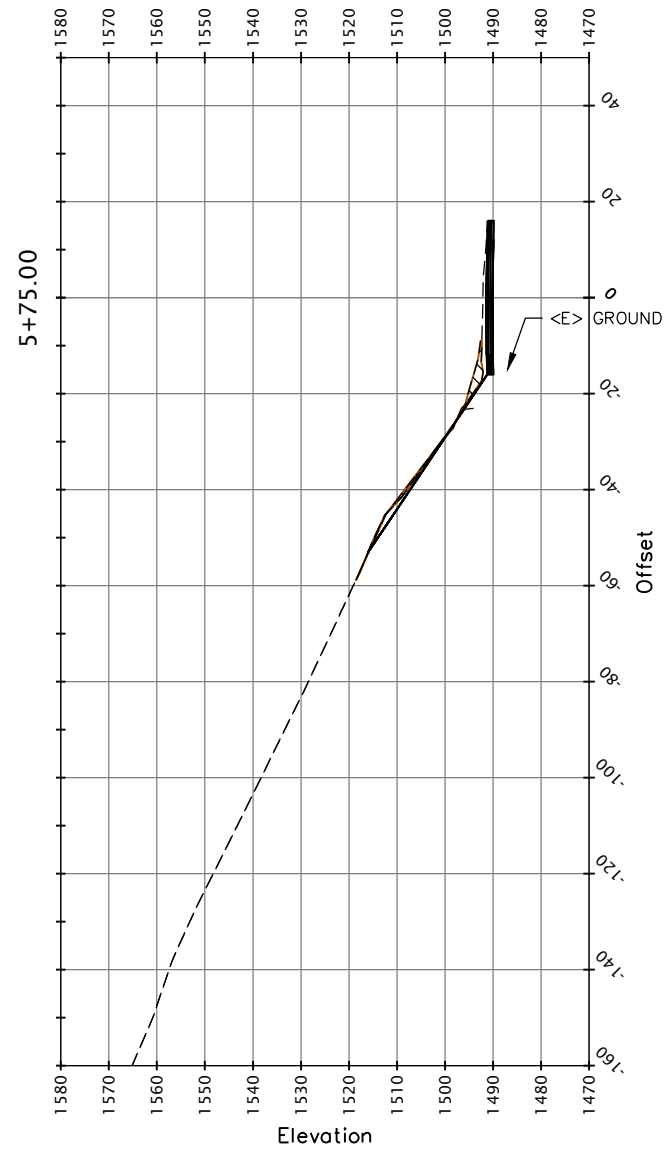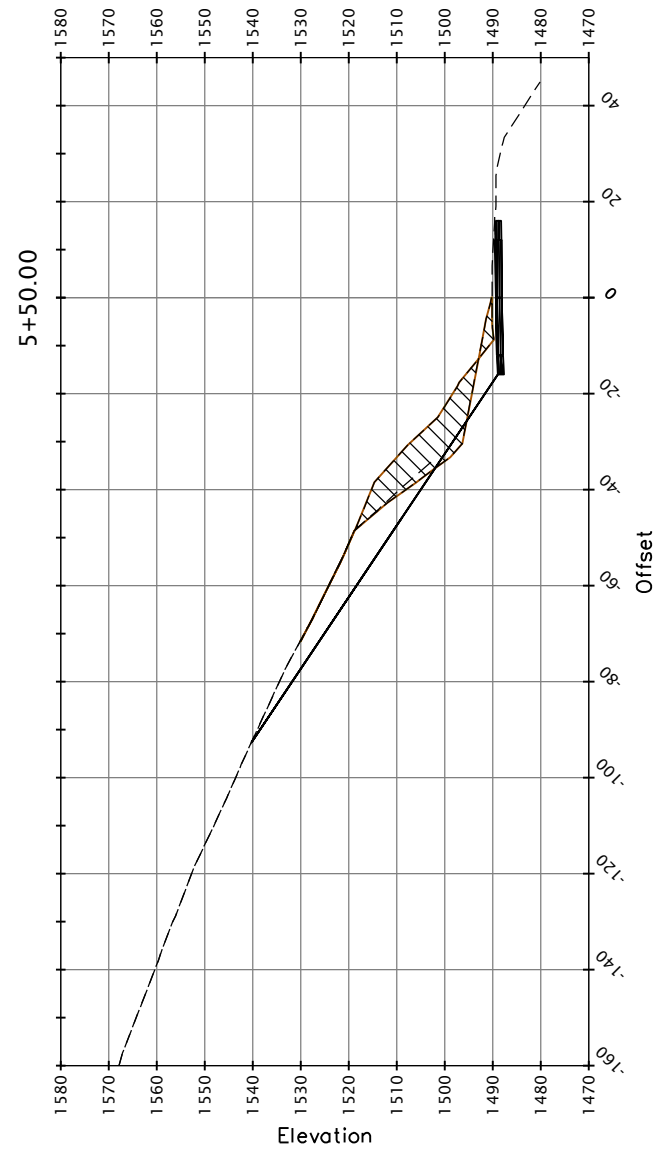

SECTION VIEWS
 SCALE: 1" = 20'

Total Volume Table						
Station	Fill Area	Cut Area	Fill Volume	Cut Volume	Cumulative Fill Vol	Cumulative Cut Vol
2+50.00	0.00	0.00	0.00	0.00	0.00	0.00
2+75.00	2.36	42.55	1.16	21.97	1.16	21.97
3+00.00	2.49	183.41	2.25	104.61	3.40	126.58
3+25.00	0.66	317.65	1.46	231.97	4.86	358.56
3+50.00	5.38	420.74	2.79	341.85	7.65	700.40
3+75.00	16.01	278.73	9.90	323.83	17.55	1024.23
4+00.00	15.32	230.56	14.50	235.78	32.06	1260.01
4+25.00	16.46	403.13	14.54	272.38	46.60	1532.39
4+50.00	21.87	524.30	17.54	381.88	64.13	1914.27
4+75.00	2.68	594.71	11.27	464.66	75.41	2378.93
5+00.00	0.19	525.43	1.30	467.54	76.71	2846.47
5+25.00	0.59	545.12	0.35	469.15	77.06	3315.62
5+50.00	16.41	211.72	7.87	350.39	84.93	3666.01
5+75.00	16.52	5.33	15.24	100.49	100.18	3766.50
6+00.00	0.00	0.00	7.65	2.47	107.82	3768.96
6+25.00	0.00	0.00	0.00	0.00	107.82	3768.96
6+50.00	0.00	0.00	0.00	0.00	107.82	3768.96








ROAD NAME: ALDERPOINT ROAD		DESIGN SECTION
ROAD NO.: 68165	MILE POST: 2.10	ENGINEERING
PROJECT NO.: ER-3210(268)		DESIGNED BY: RMD
CONTRACT NO.: 217245		DRAWN BY: RMD
DRAWING FILE NAME: 217245_ALD_2.1		REVIEWED BY: JAB
PLOT DATE: 06/27/2024	REVISION DATE:	APPROVED BY: TRS

COUNTY OF HUMBOLDT DEPARTMENT OF PUBLIC WORKS	
STORM DAMAGE REPAIR TO ALDERPOINT ROAD PM 2.10	
ALDERPOINT ROAD SECTIONS	

SHEET
9a
OF
42

CO 3 Sheet 8 of 11 Attachment 1

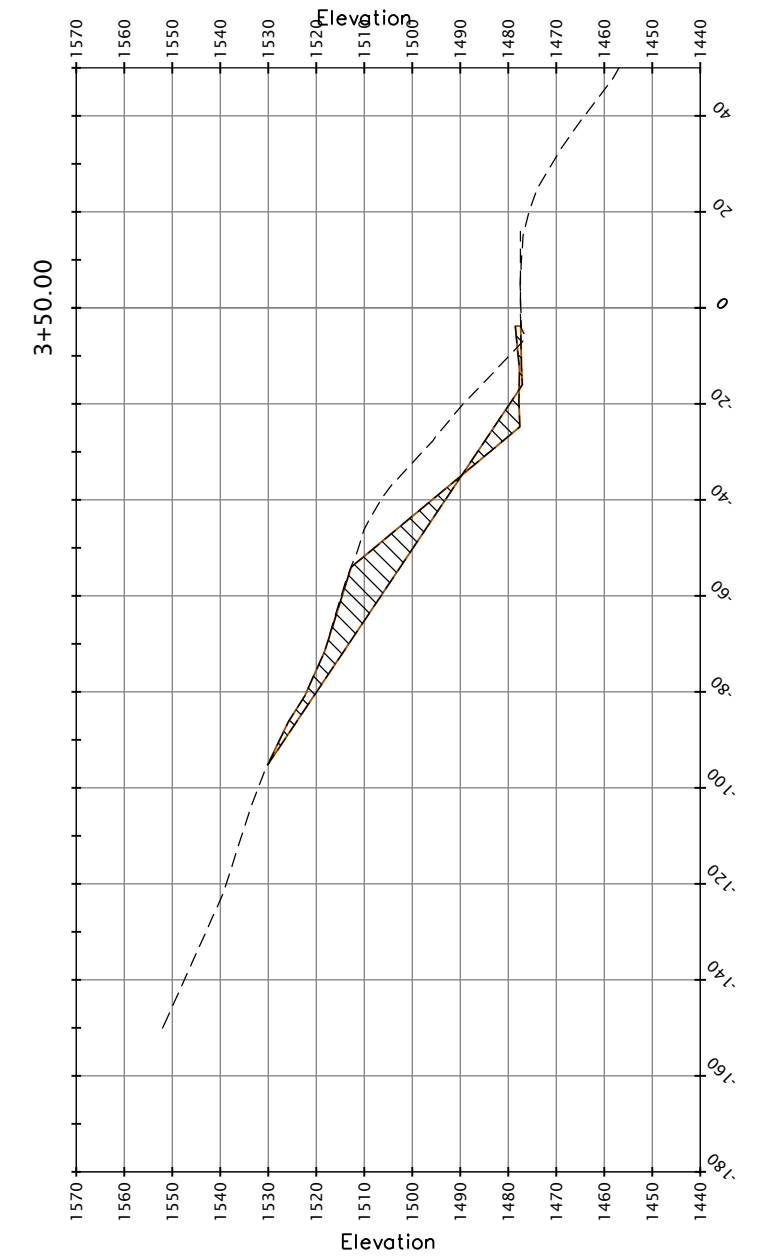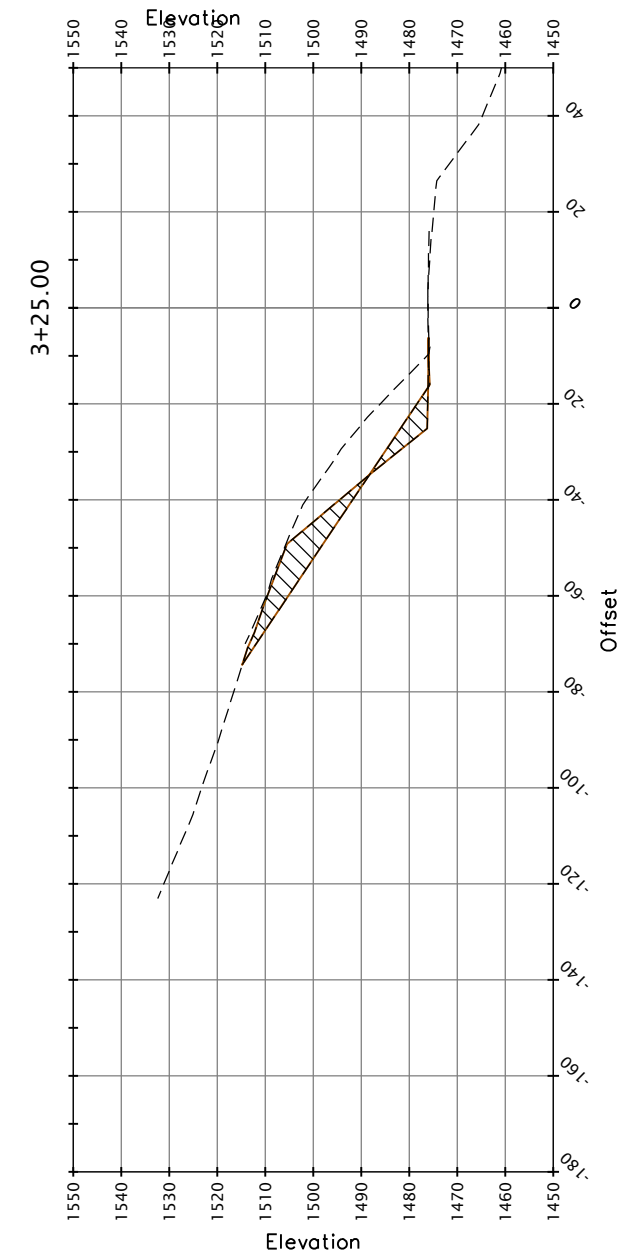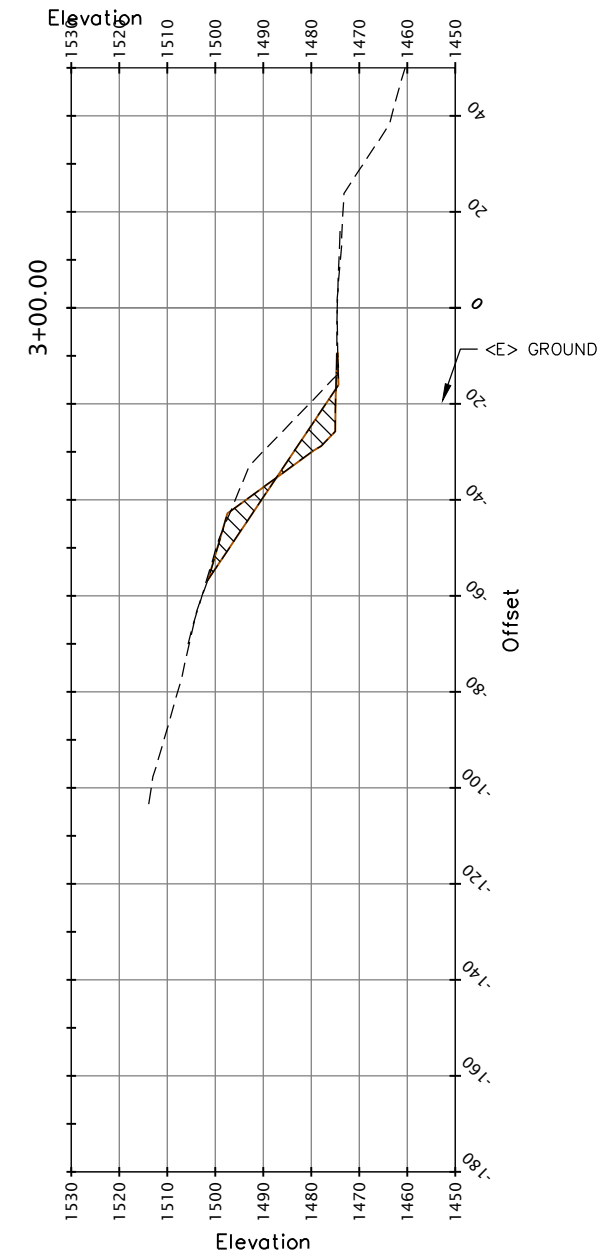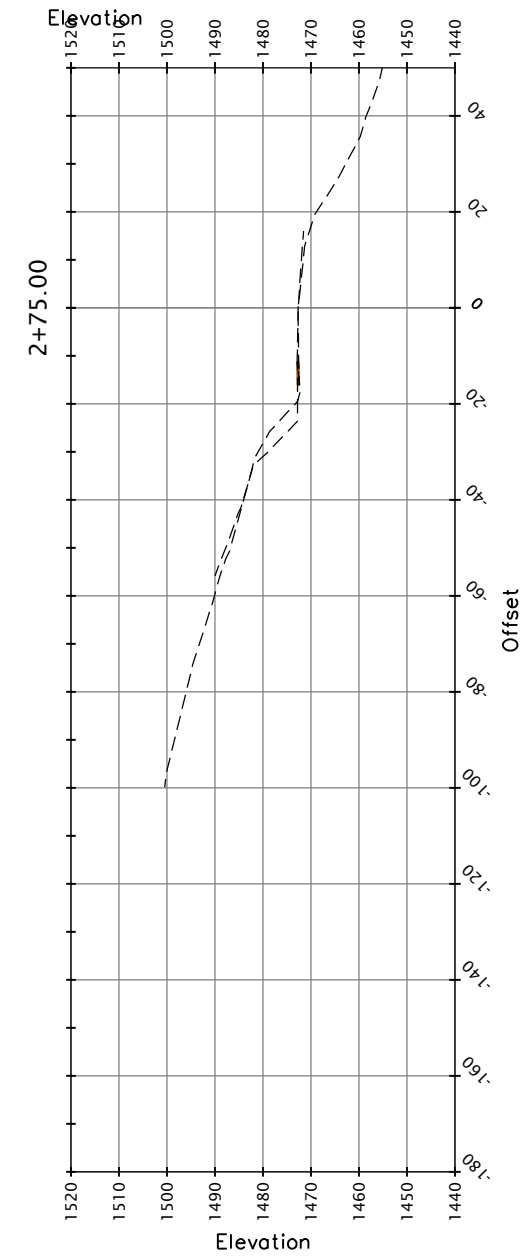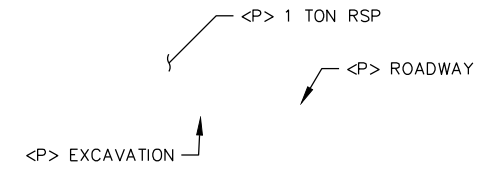

SECTION VIEWS
SCALE: 1" = 20'





BAR IS ONE INCH ON ORIGINAL DRAWING	ROAD NAME: ALDERPOINT ROAD	DESIGN SECTION ENGINEERING
IF NOT ONE INCH ON THIS SHEET, ADJUST SCALES ACCORDINGLY	ROAD NO.: 68165	MILE POST: 2.10
	PROJECT NO.: ER-3210(268)	DESIGNED BY: RMD
	CONTRACT NO.: 217245	DRAWN BY: RMD
	DRAWING FILE NAME: 217245 ALD 2.1	REVIEWED BY: JAB
	PLOT DATE: 06/27/2024	REVISION DATE:
		APPROVED BY: TRS

COUNTY OF HUMBOLDT DEPARTMENT OF PUBLIC WORKS
STORM DAMAGE REPAIR TO ALDERPOINT ROAD PM 2.10
ALDERPOINT ROAD SECTIONS

SHEET
9b
OF
42

CO 3 Sheet 9 of 11 Attachment 1

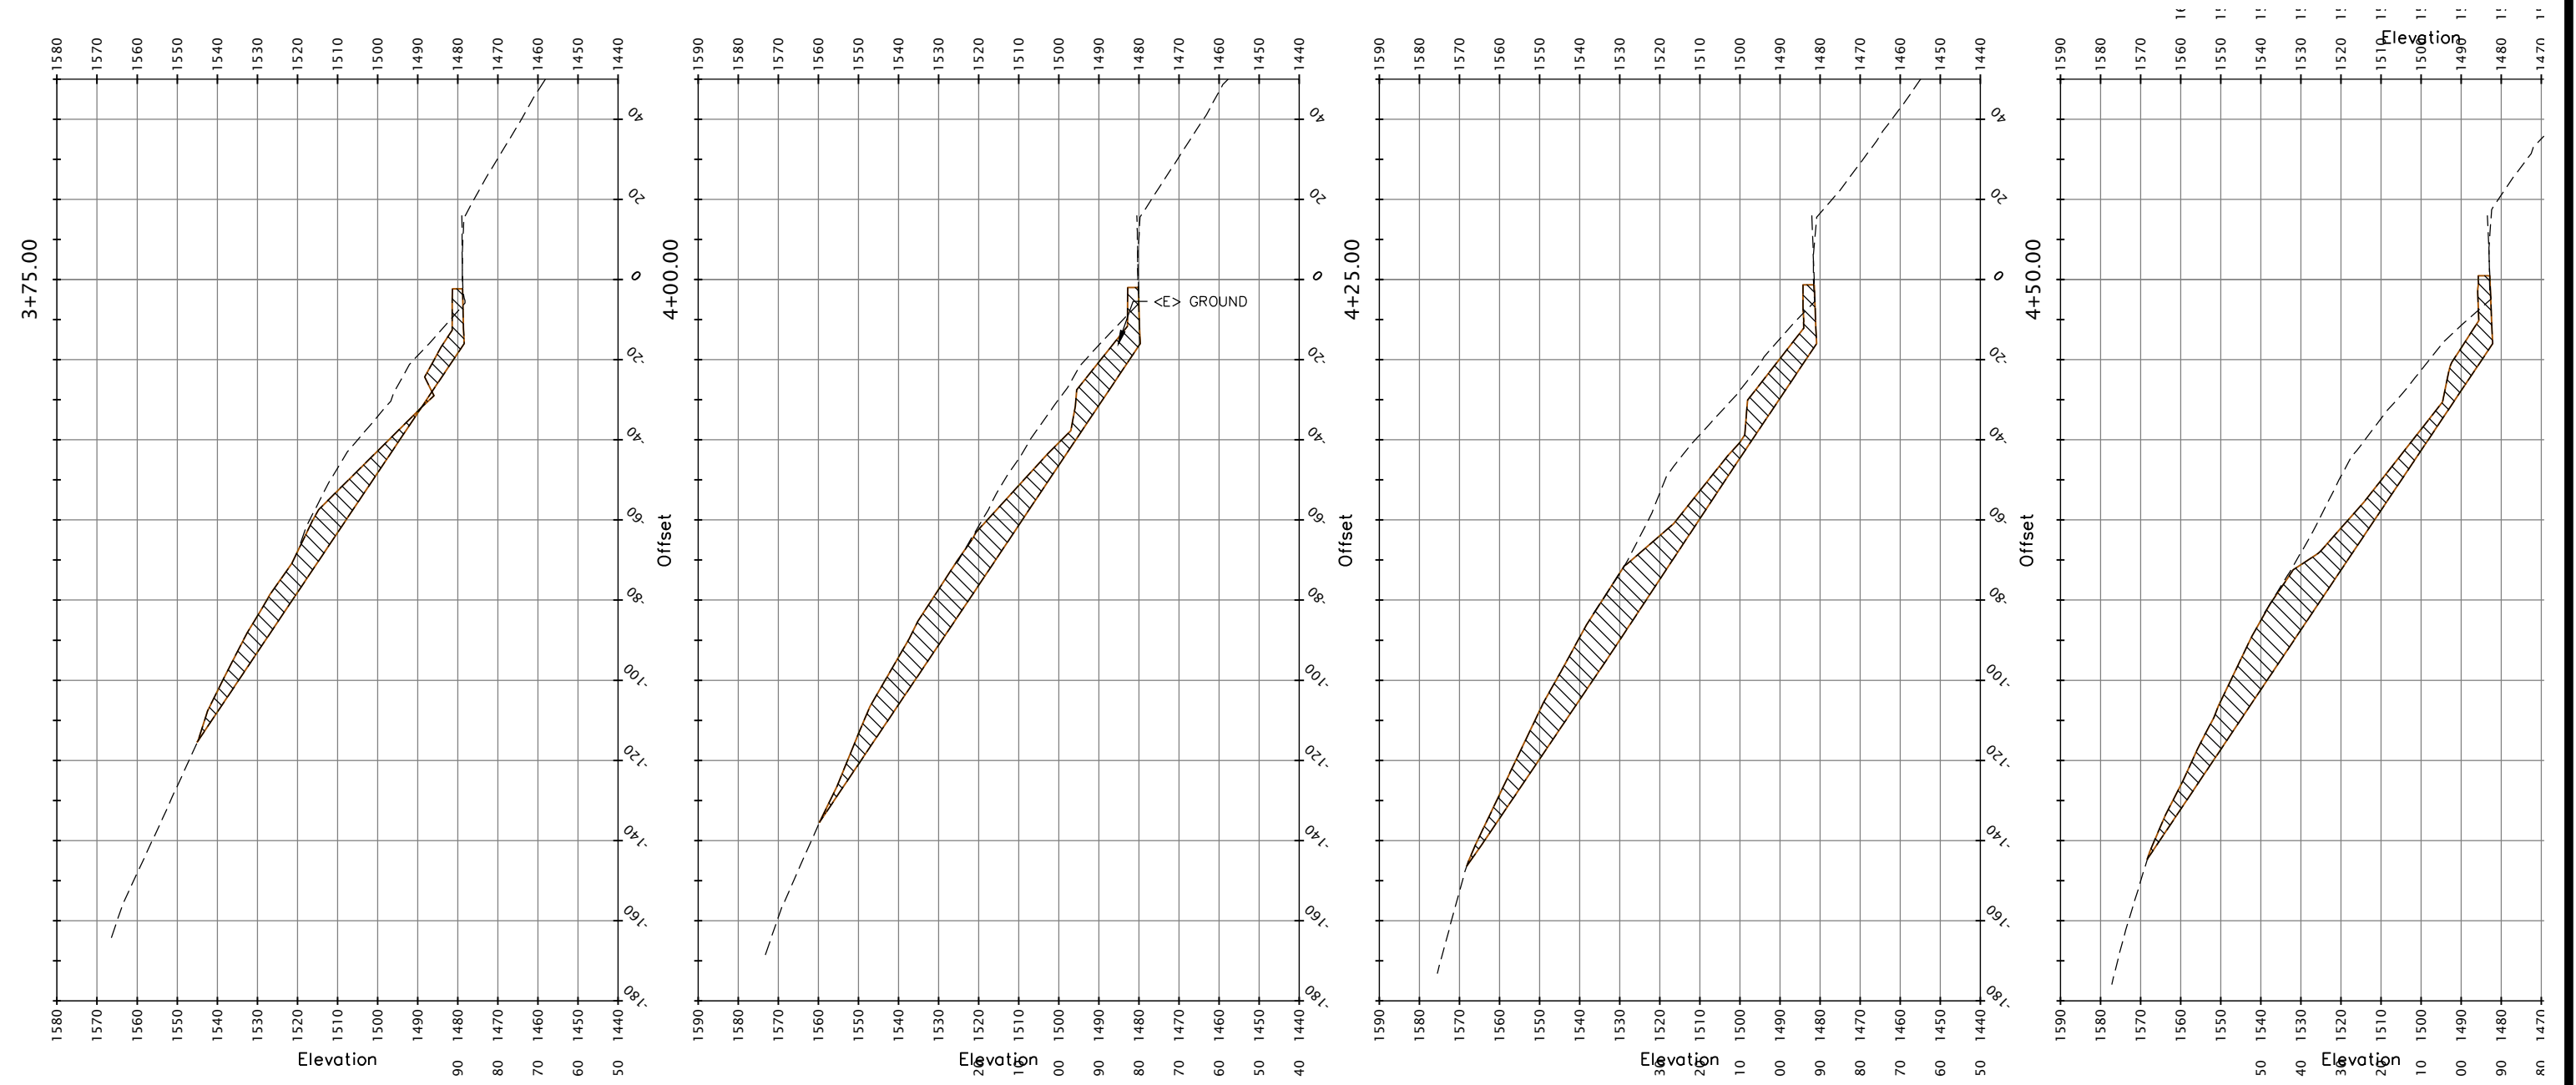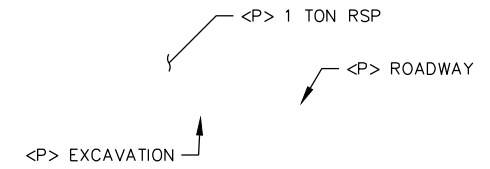

SECTION VIEWS
SCALE: 1" = 20'








ROAD NAME: ALDERPOINT ROAD		DESIGN SECTION
ROAD NO.: 6B165	MILE POST: 2.10	ENGINEERING
PROJECT NO.: ER-3210(268)		DESIGNED BY: RMD
CONTRACT NO.: 217245		DRAWN BY: RMD
DRAWING FILE NAME: 217245_ALD_2.1		REVIEWED BY: JAB
PLOT DATE: 06/27/2024	REVISION DATE:	APPROVED BY: TRS

COUNTY OF HUMBOLDT DEPARTMENT OF PUBLIC WORKS	
STORM DAMAGE REPAIR TO ALDERPOINT ROAD PM 2.10	
ALDERPOINT ROAD SECTIONS	

SHEET
9c
OF
42

CO 3 Sheet 10 of 11 Attachment 1

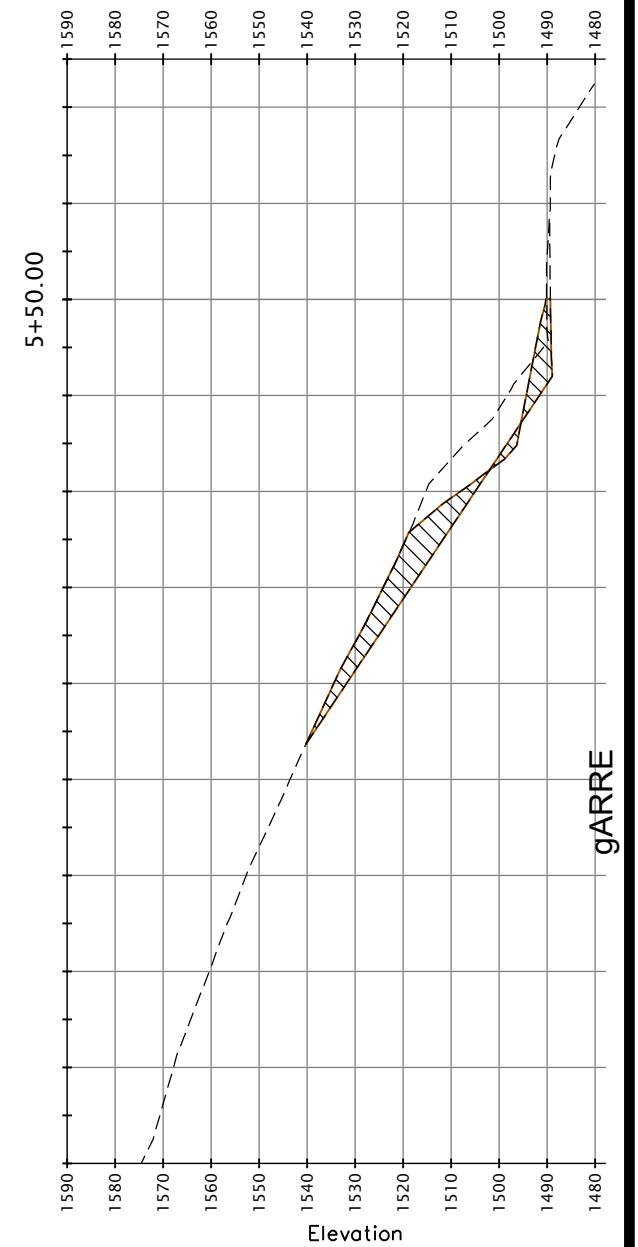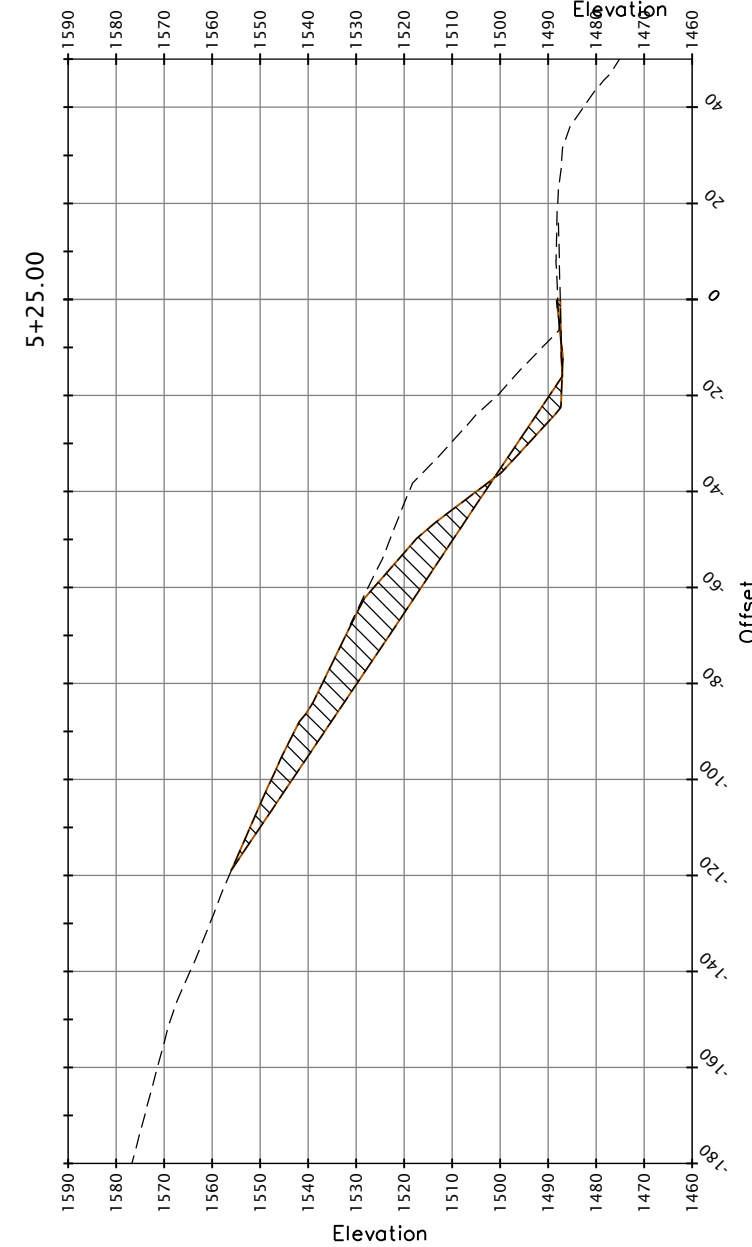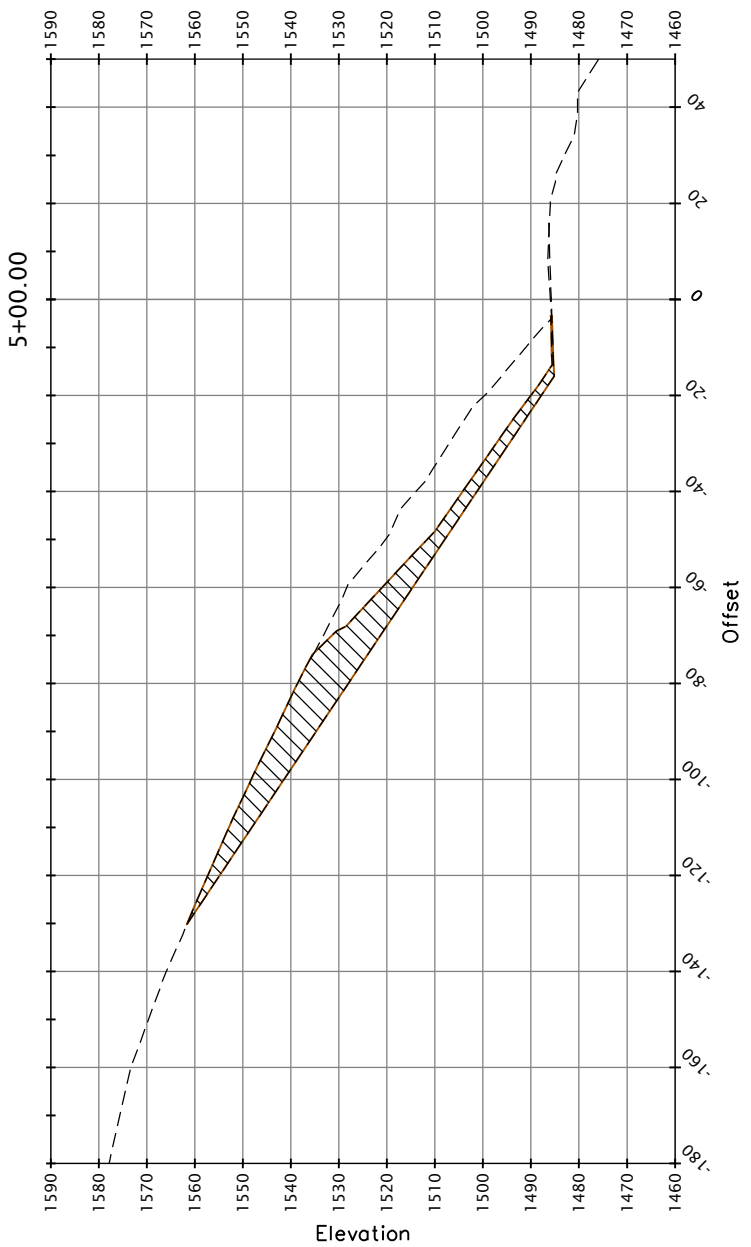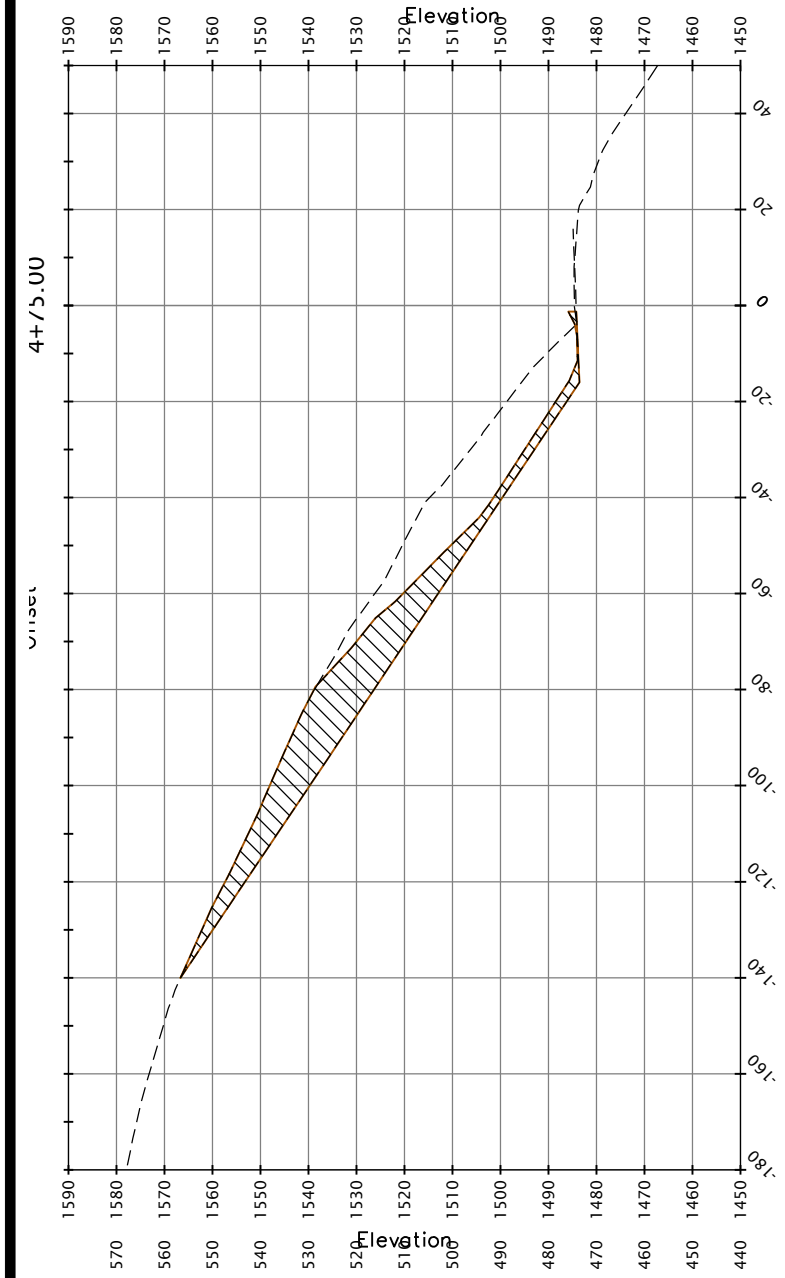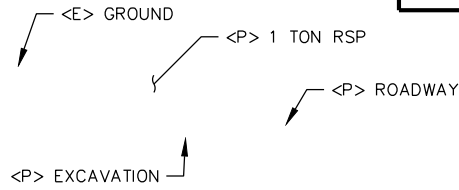

SECTION VIEWS
SCALE: 1" = 20'






ROAD NAME: ALDERPOINT ROAD	DESIGN SECTION
ROAD NO.: 68165	ENGINEERING
MILE POST: 2.10	DESIGNED BY: RMD
PROJECT NO.: ER-3210(268)	DRAWN BY: RMD
CONTRACT NO.: 217245	REVIEWED BY: JAB
DRAWING FILE NAME: 217245_ALD_2.1	APPROVED BY: TRS
PLOT DATE: 06/27/2024	REVISION DATE:

COUNTY OF HUMBOLDT DEPARTMENT OF PUBLIC WORKS
STORM DAMAGE REPAIR TO ALDERPOINT ROAD PM 2.10
ALDERPOINT ROAD SECTIONS

SHEET
9d
OF
42

CO 3 Sheet 11 of 11 Attachment 1

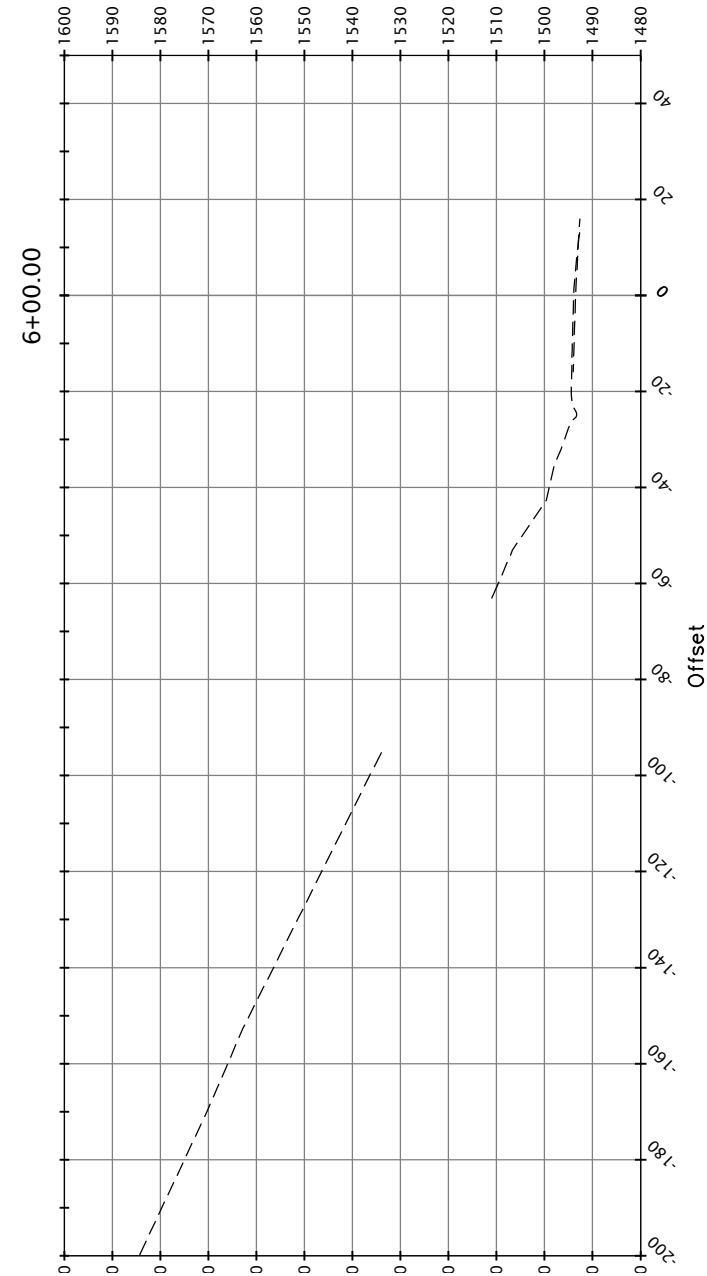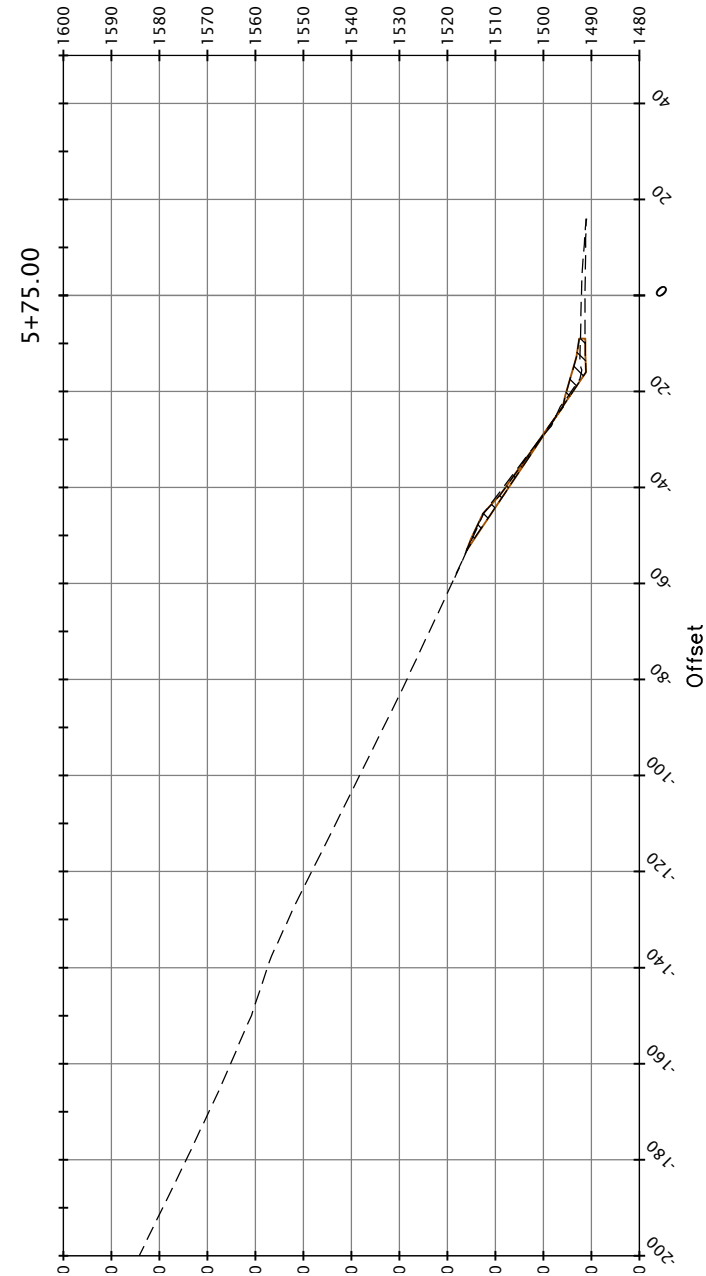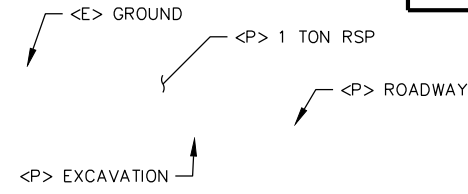

Station	Fill Area	Cut Area	Fill Volume	Cut Volume	Cumulative Fill Vol	Cumulative Cut Vol
2+50.00	0.00	0.00	0.00	0.00	0.00	0.00
2+75.00	0.00	1.38	0.00	0.67	0.00	0.67
3+00.00	57.21	57.55	26.48	27.28	26.48	27.95
3+25.00	50.92	151.39	50.06	96.73	76.54	124.69
3+50.00	46.97	276.17	45.32	197.95	121.86	322.63
3+75.00	2.24	500.90	22.79	359.75	144.65	682.39
4+00.00	0.00	814.29	1.04	608.89	145.69	1291.27
4+25.00	0.00	907.61	0.00	696.91	145.69	1988.18
4+50.00	0.00	906.00	0.00	673.97	145.69	2662.15
4+75.00	0.00	725.88	0.00	601.41	145.69	3263.56
5+00.00	0.00	618.10	0.00	492.72	145.69	3756.28
5+25.00	48.48	484.78	21.55	451.50	167.24	4207.78
5+50.00	12.45	303.90	28.21	365.13	195.45	4572.91
5+75.00	0.07	41.63	5.80	159.97	201.24	4732.88
6+00.00	0.00	0.00	0.03	19.27	201.27	4752.15
6+25.00	0.00	0.00	0.00	0.00	201.27	4752.15
6+50.00	0.00	0.00	0.00	0.00	201.27	4752.15

SECTION VIEWS
SCALE: 1" = 20'