


ACGC KOSTER SHOP

1606 KOSTER ST.
 EUREKA, CA 95501
 APN: 003-172-011-000
 2.24.2025

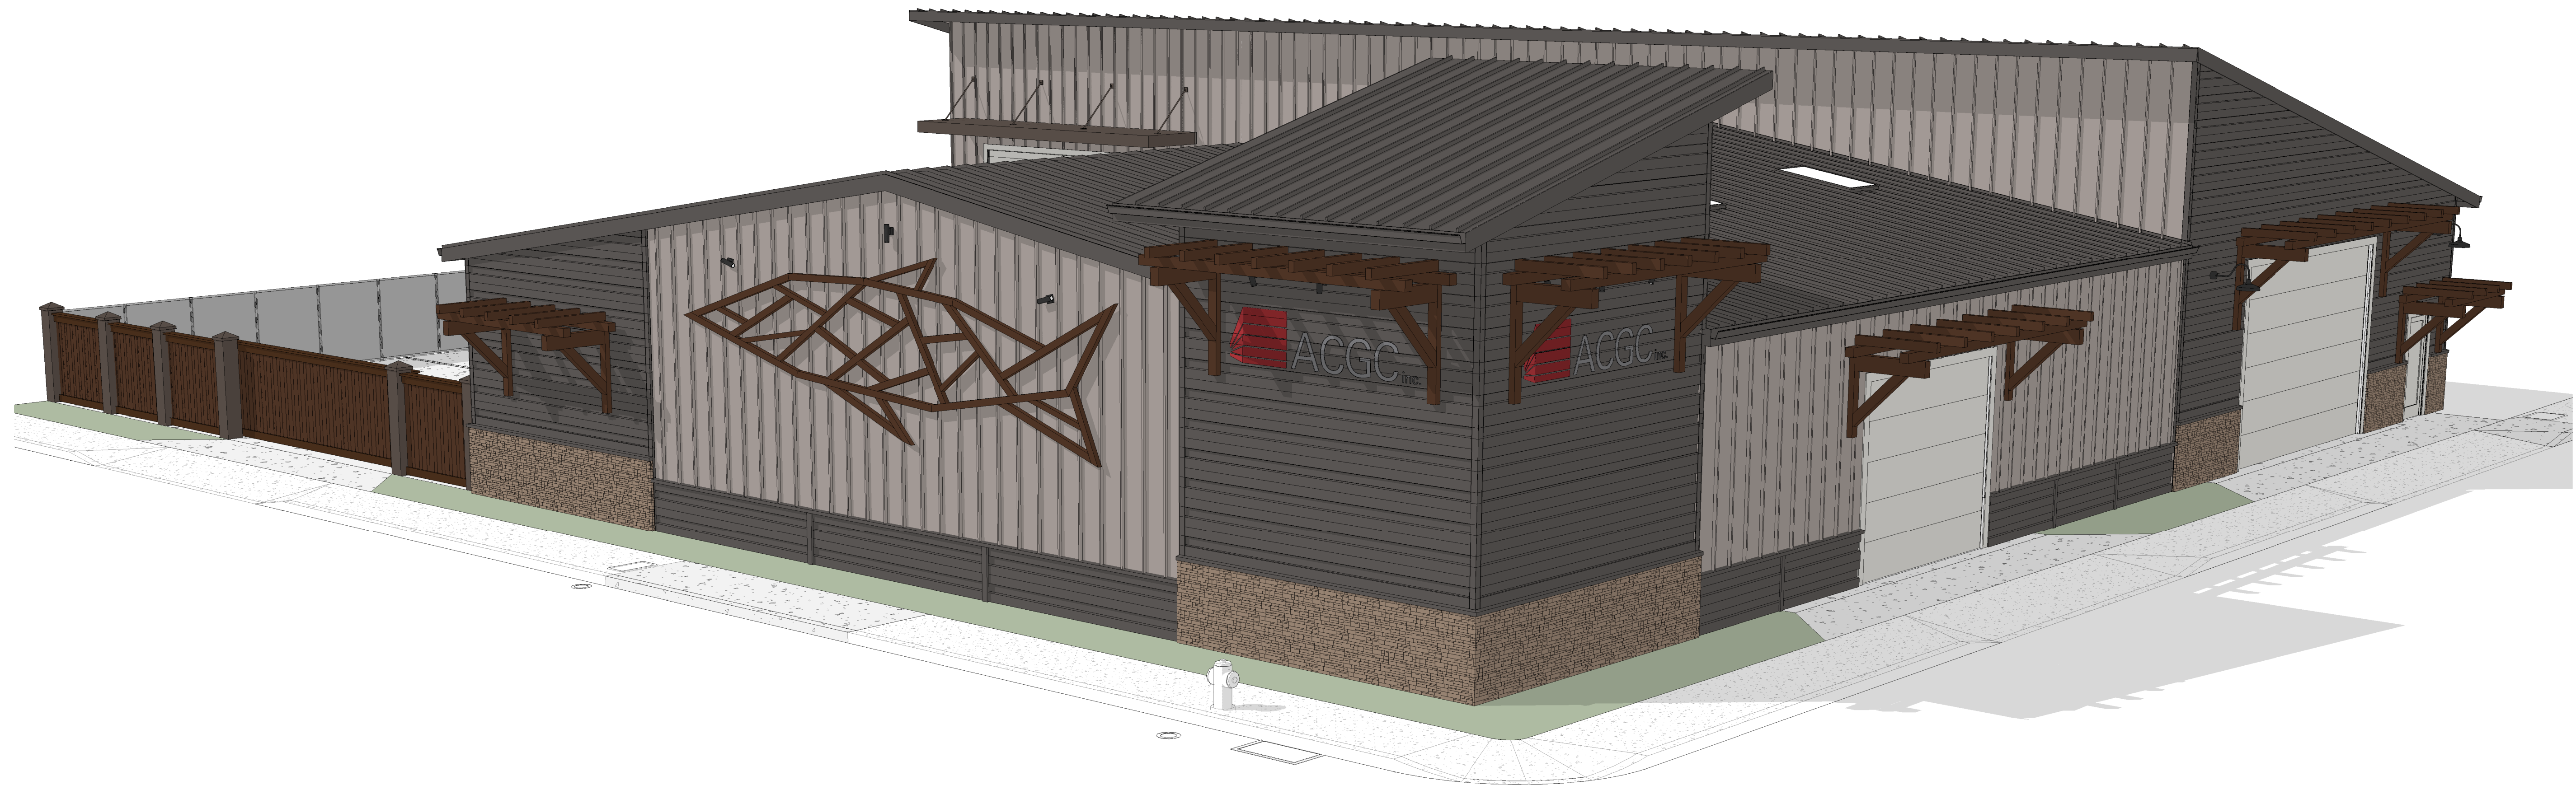

ORY
 DRAFTING & DESIGN
 Catherine Ory
 P.O. Box 7066
 Eureka, CA 95502
 707.499.5342
 www.orydrafting.com
 cat@orydrafting.com

ACGC inc.
 ADAMS COMMERCIAL GENERAL CONTRACTING
 Lic # 875823
 339 2nd St.
 EUREKA, CA 95501
 T: 707.496.3348
 F: 707.268.8381
 www.acgcinc.com

ACGC KOSTER SHOP
 1606 KOSTER ST.
 EUREKA, CA 95501
 APN 003-172-011-000

COVER SHEET
 PRELIMINARY - NOT FOR CONSTRUCTION

REVISIONS	
#	DESCRIPTION




SHEET DATE: 2.24.2025
 DRAWN BY: CAT ORY

SHEET NO.
A-0

ACGC KOSTER SHOP

REVISIONS

#	DATE	DESCRIPTION
1	3.31.2025	DESIGN REVIEW COMMENTS

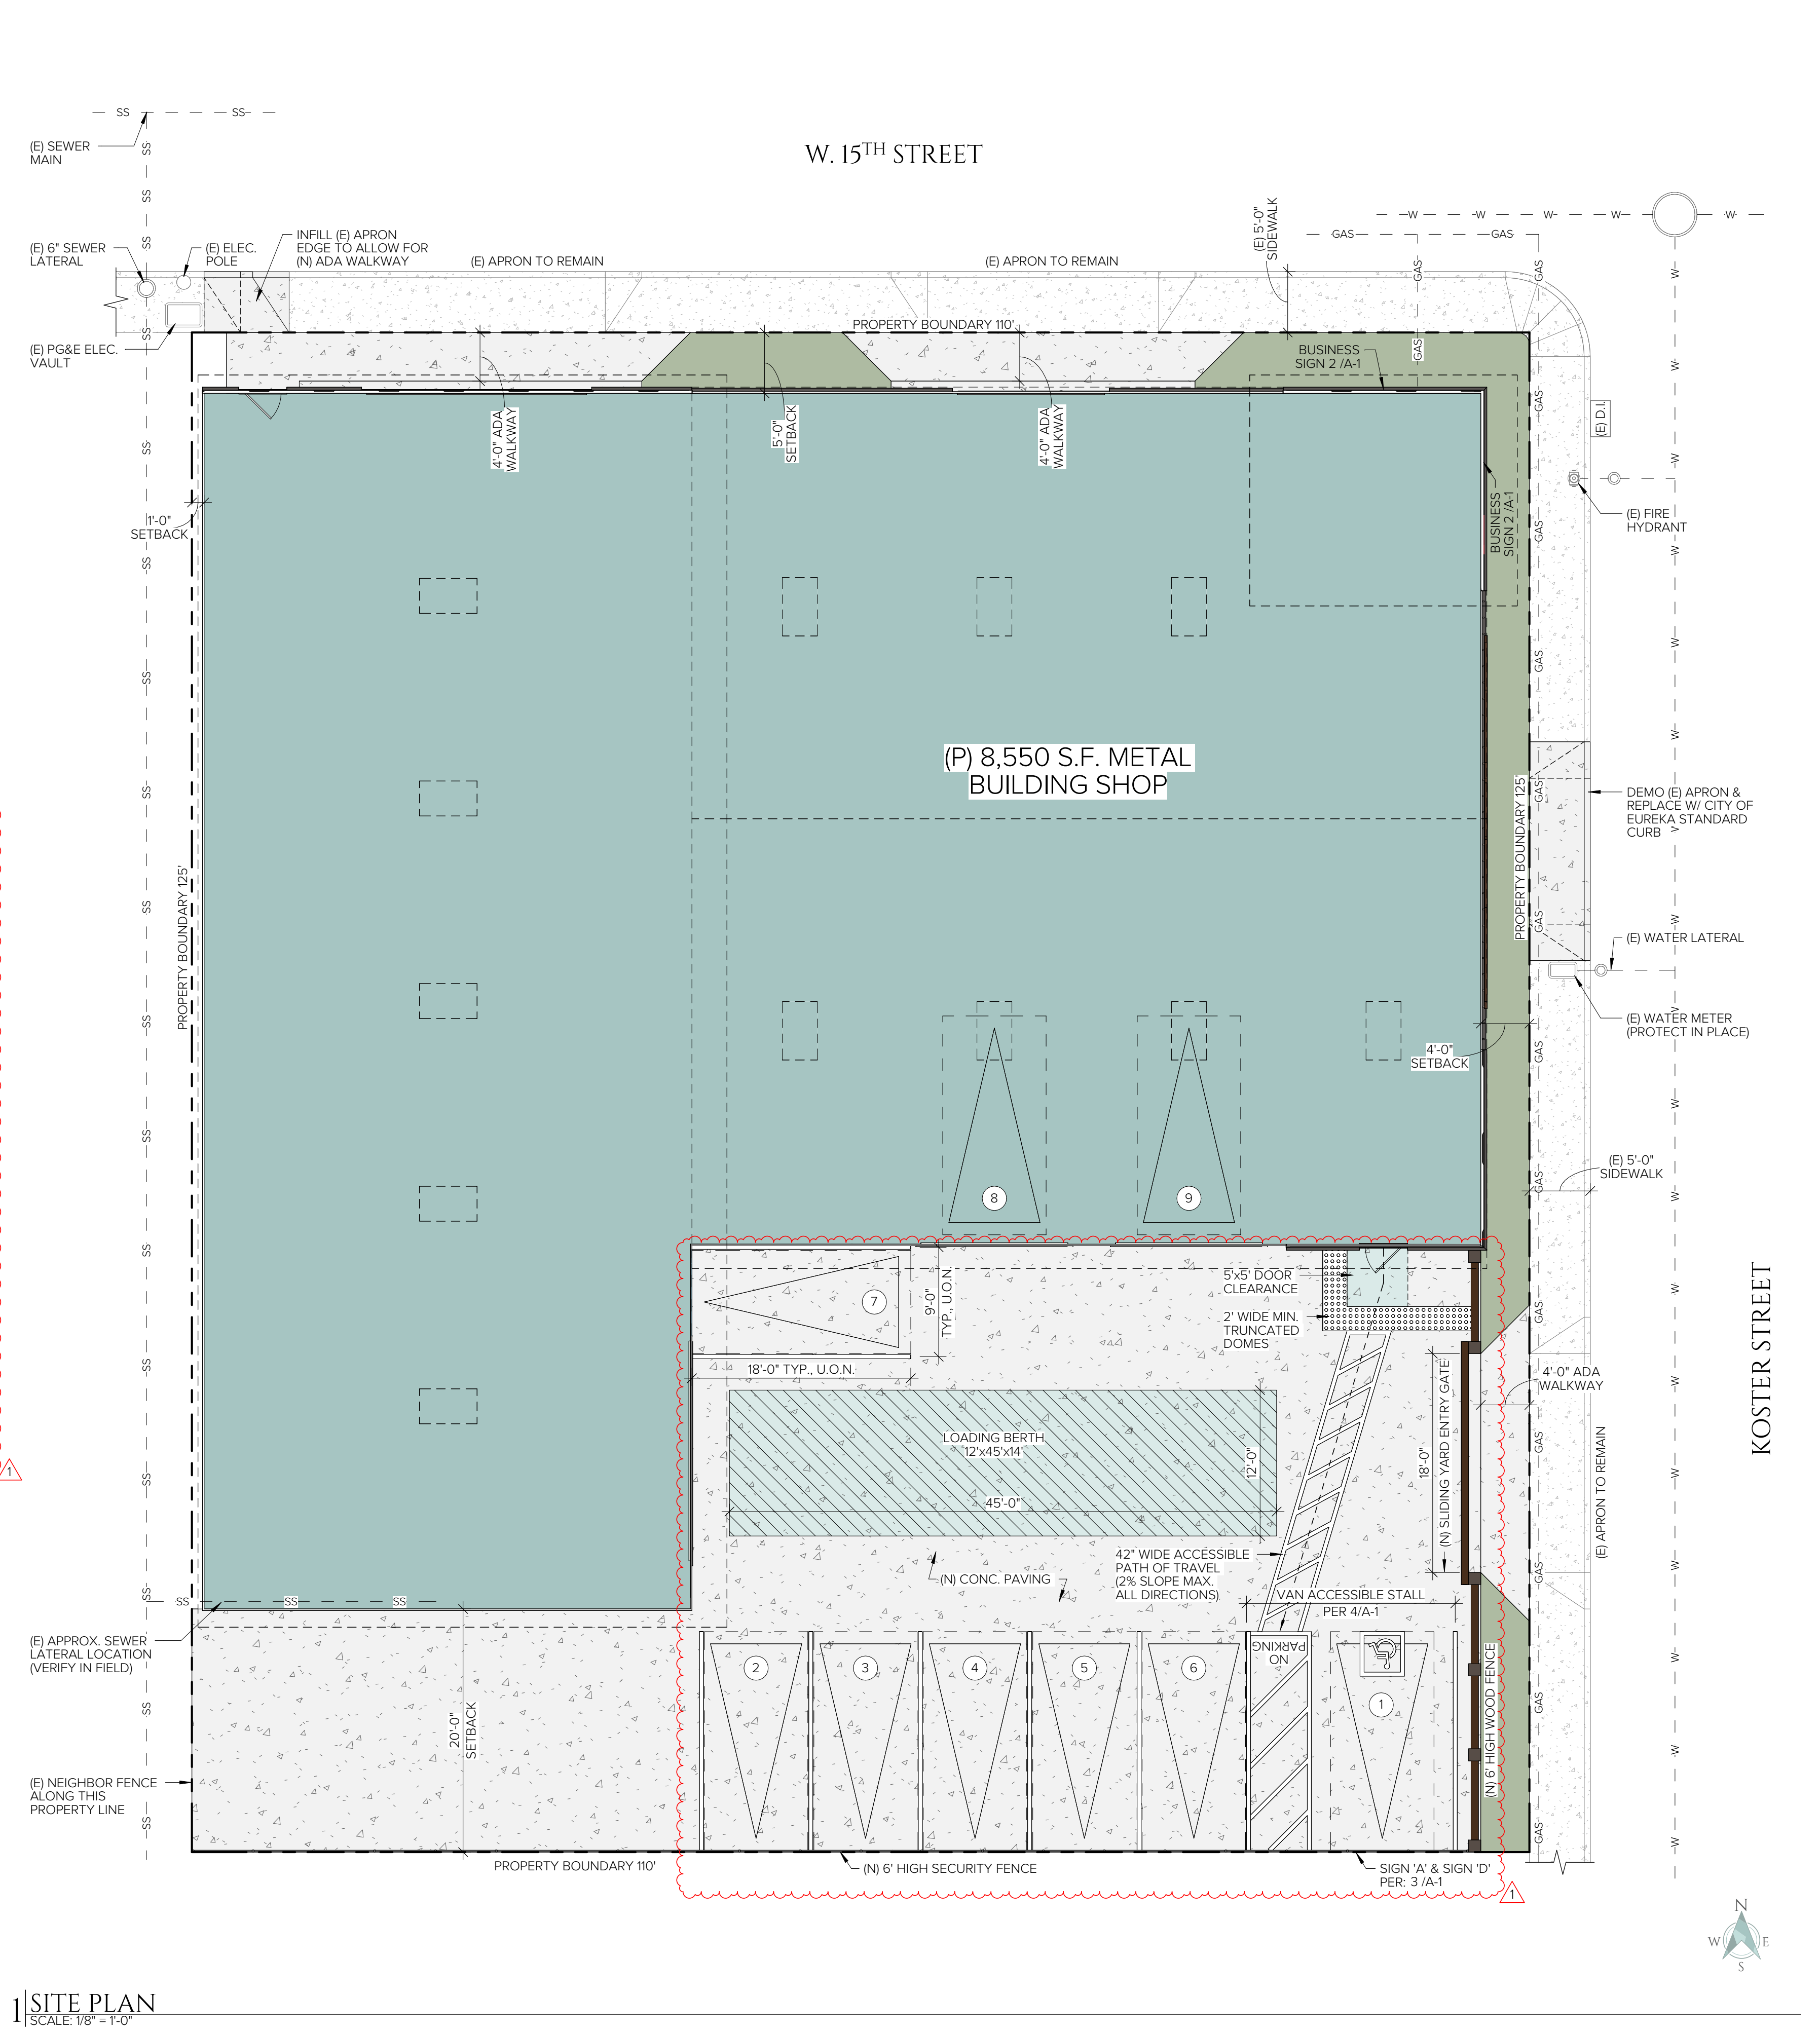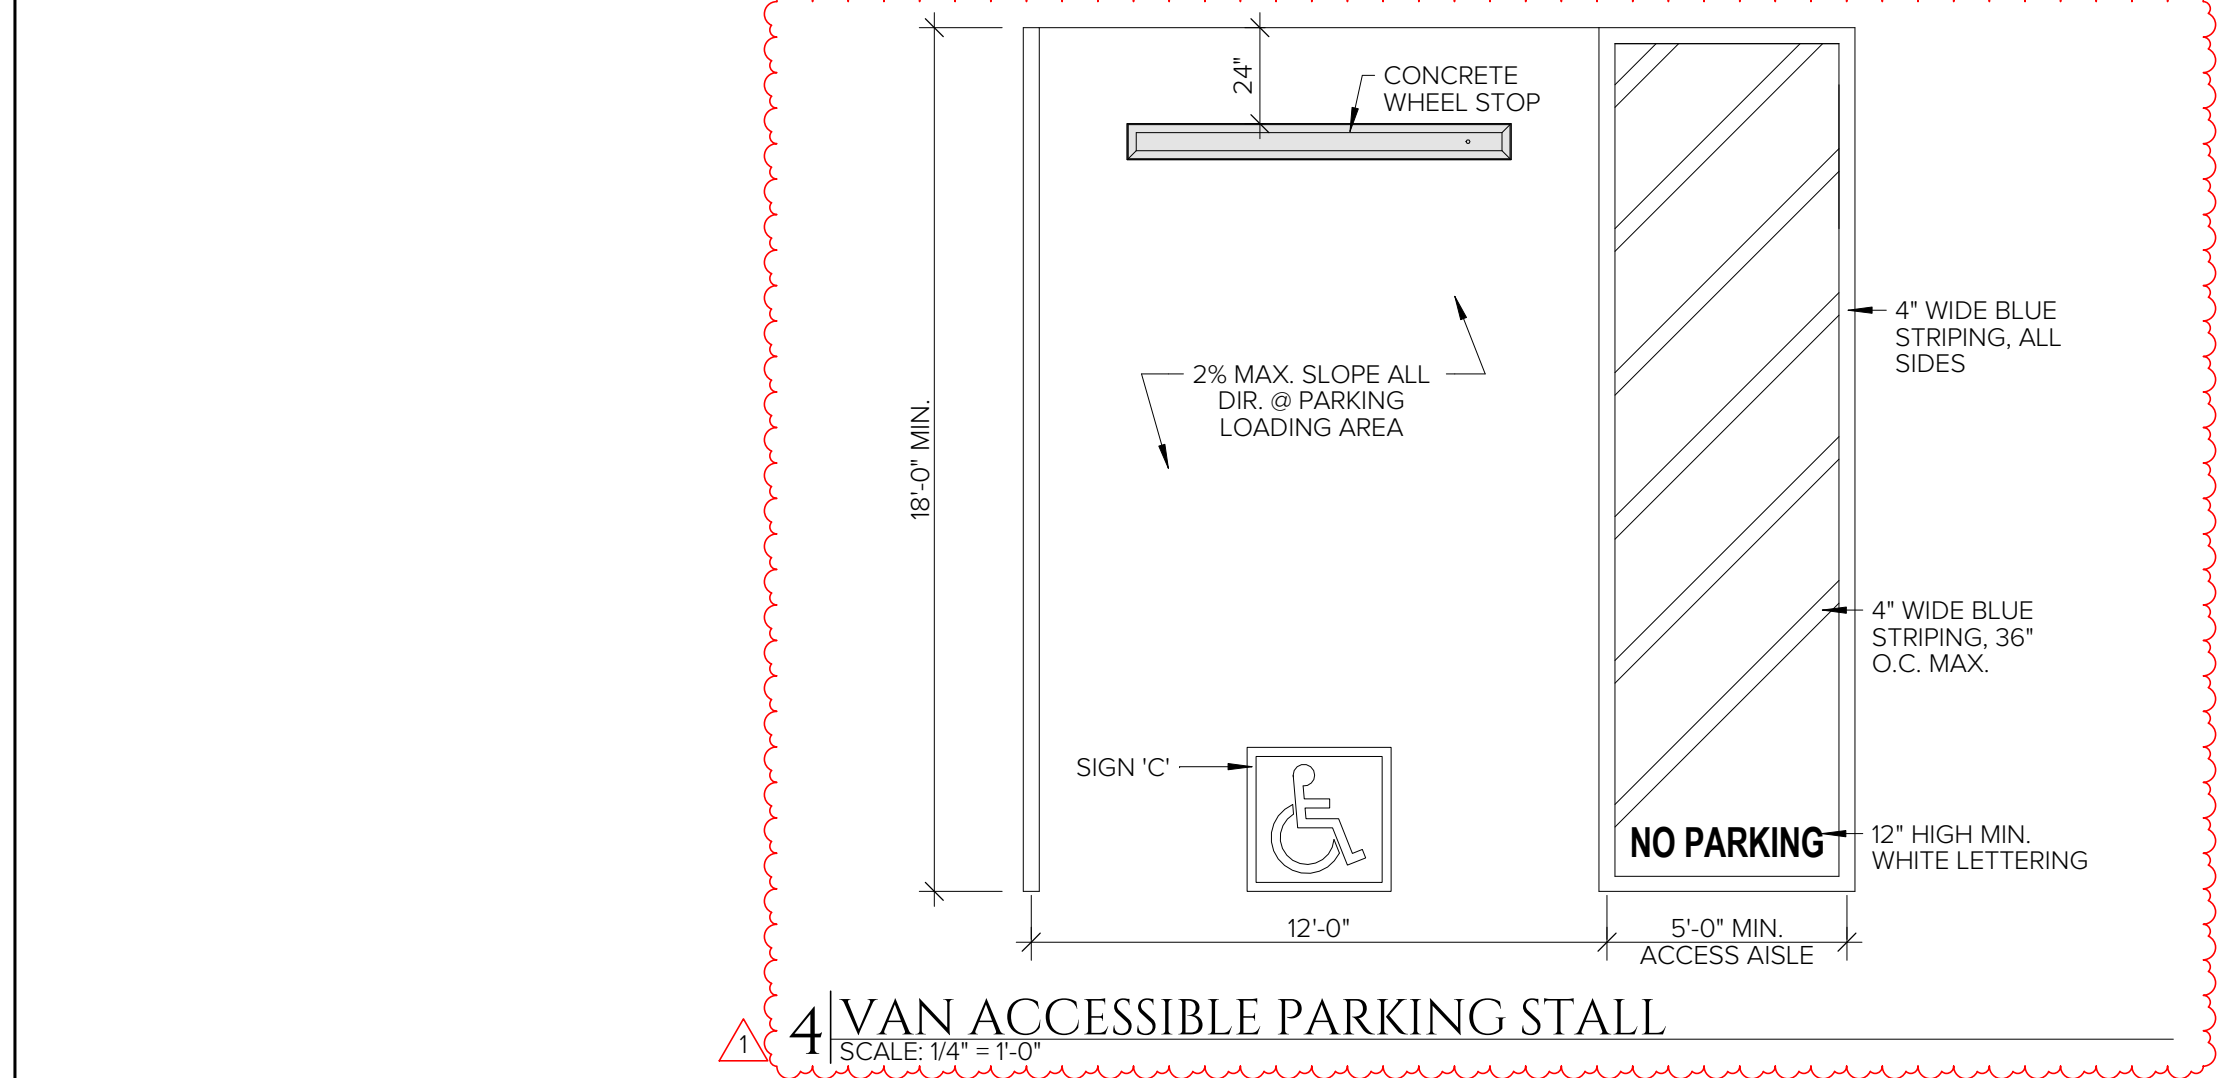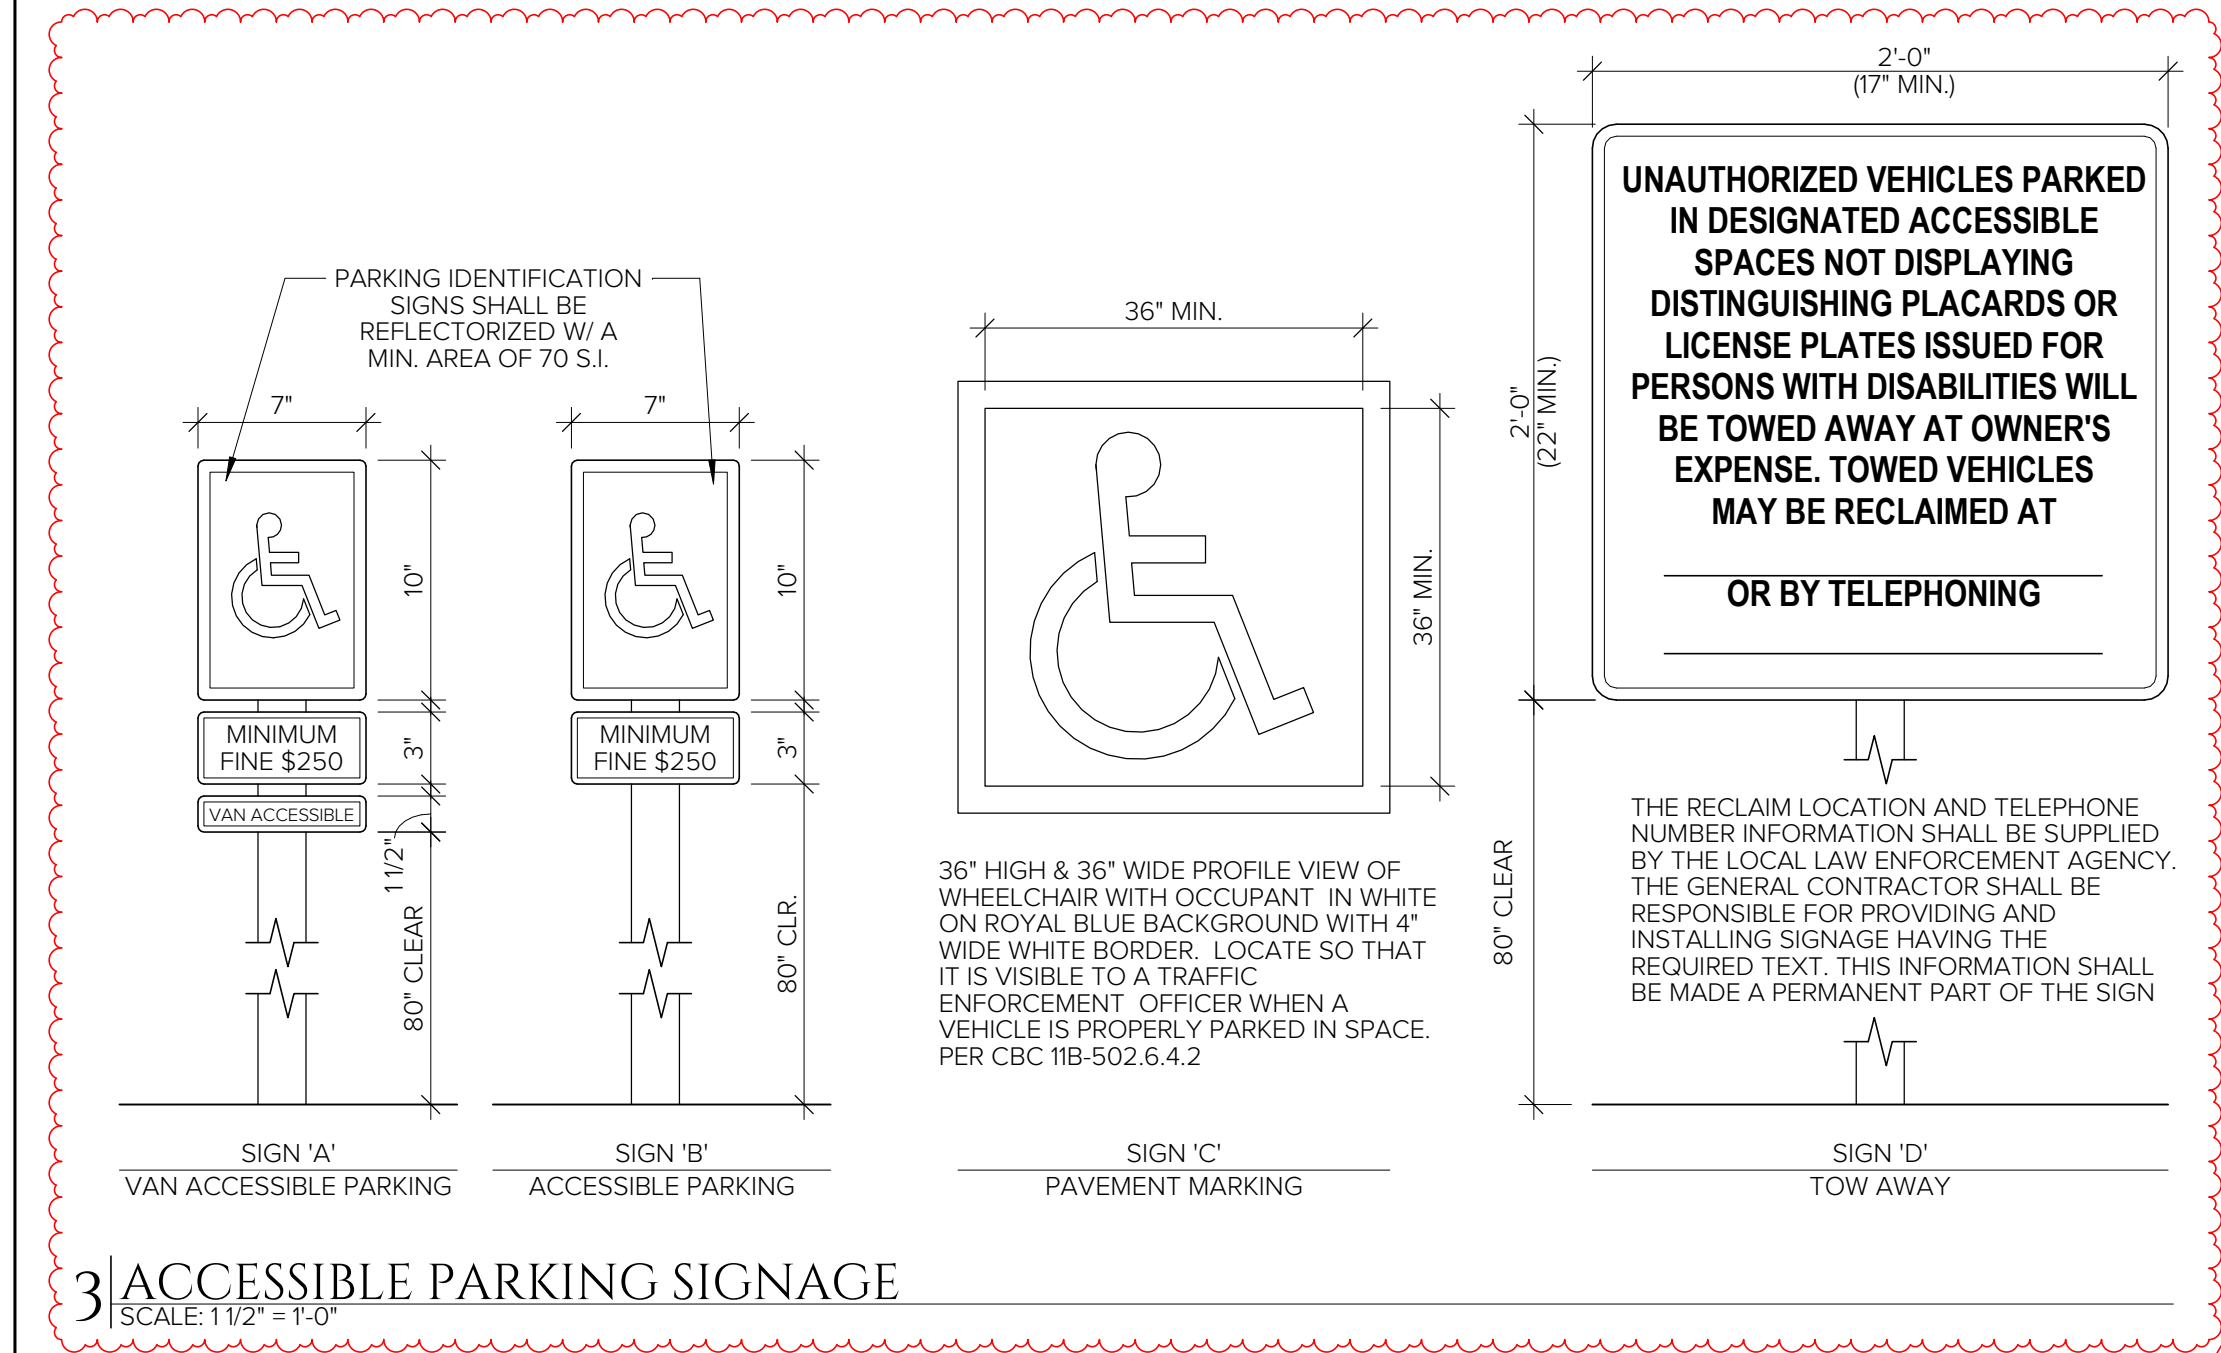

REVISIONS


#	DATE	DESCRIPTION

SHEET DATE: 2.24.2025
DRAWN BY: CAT ORY


SHEET NO.

A-2

ACGC KOSTER SHOP

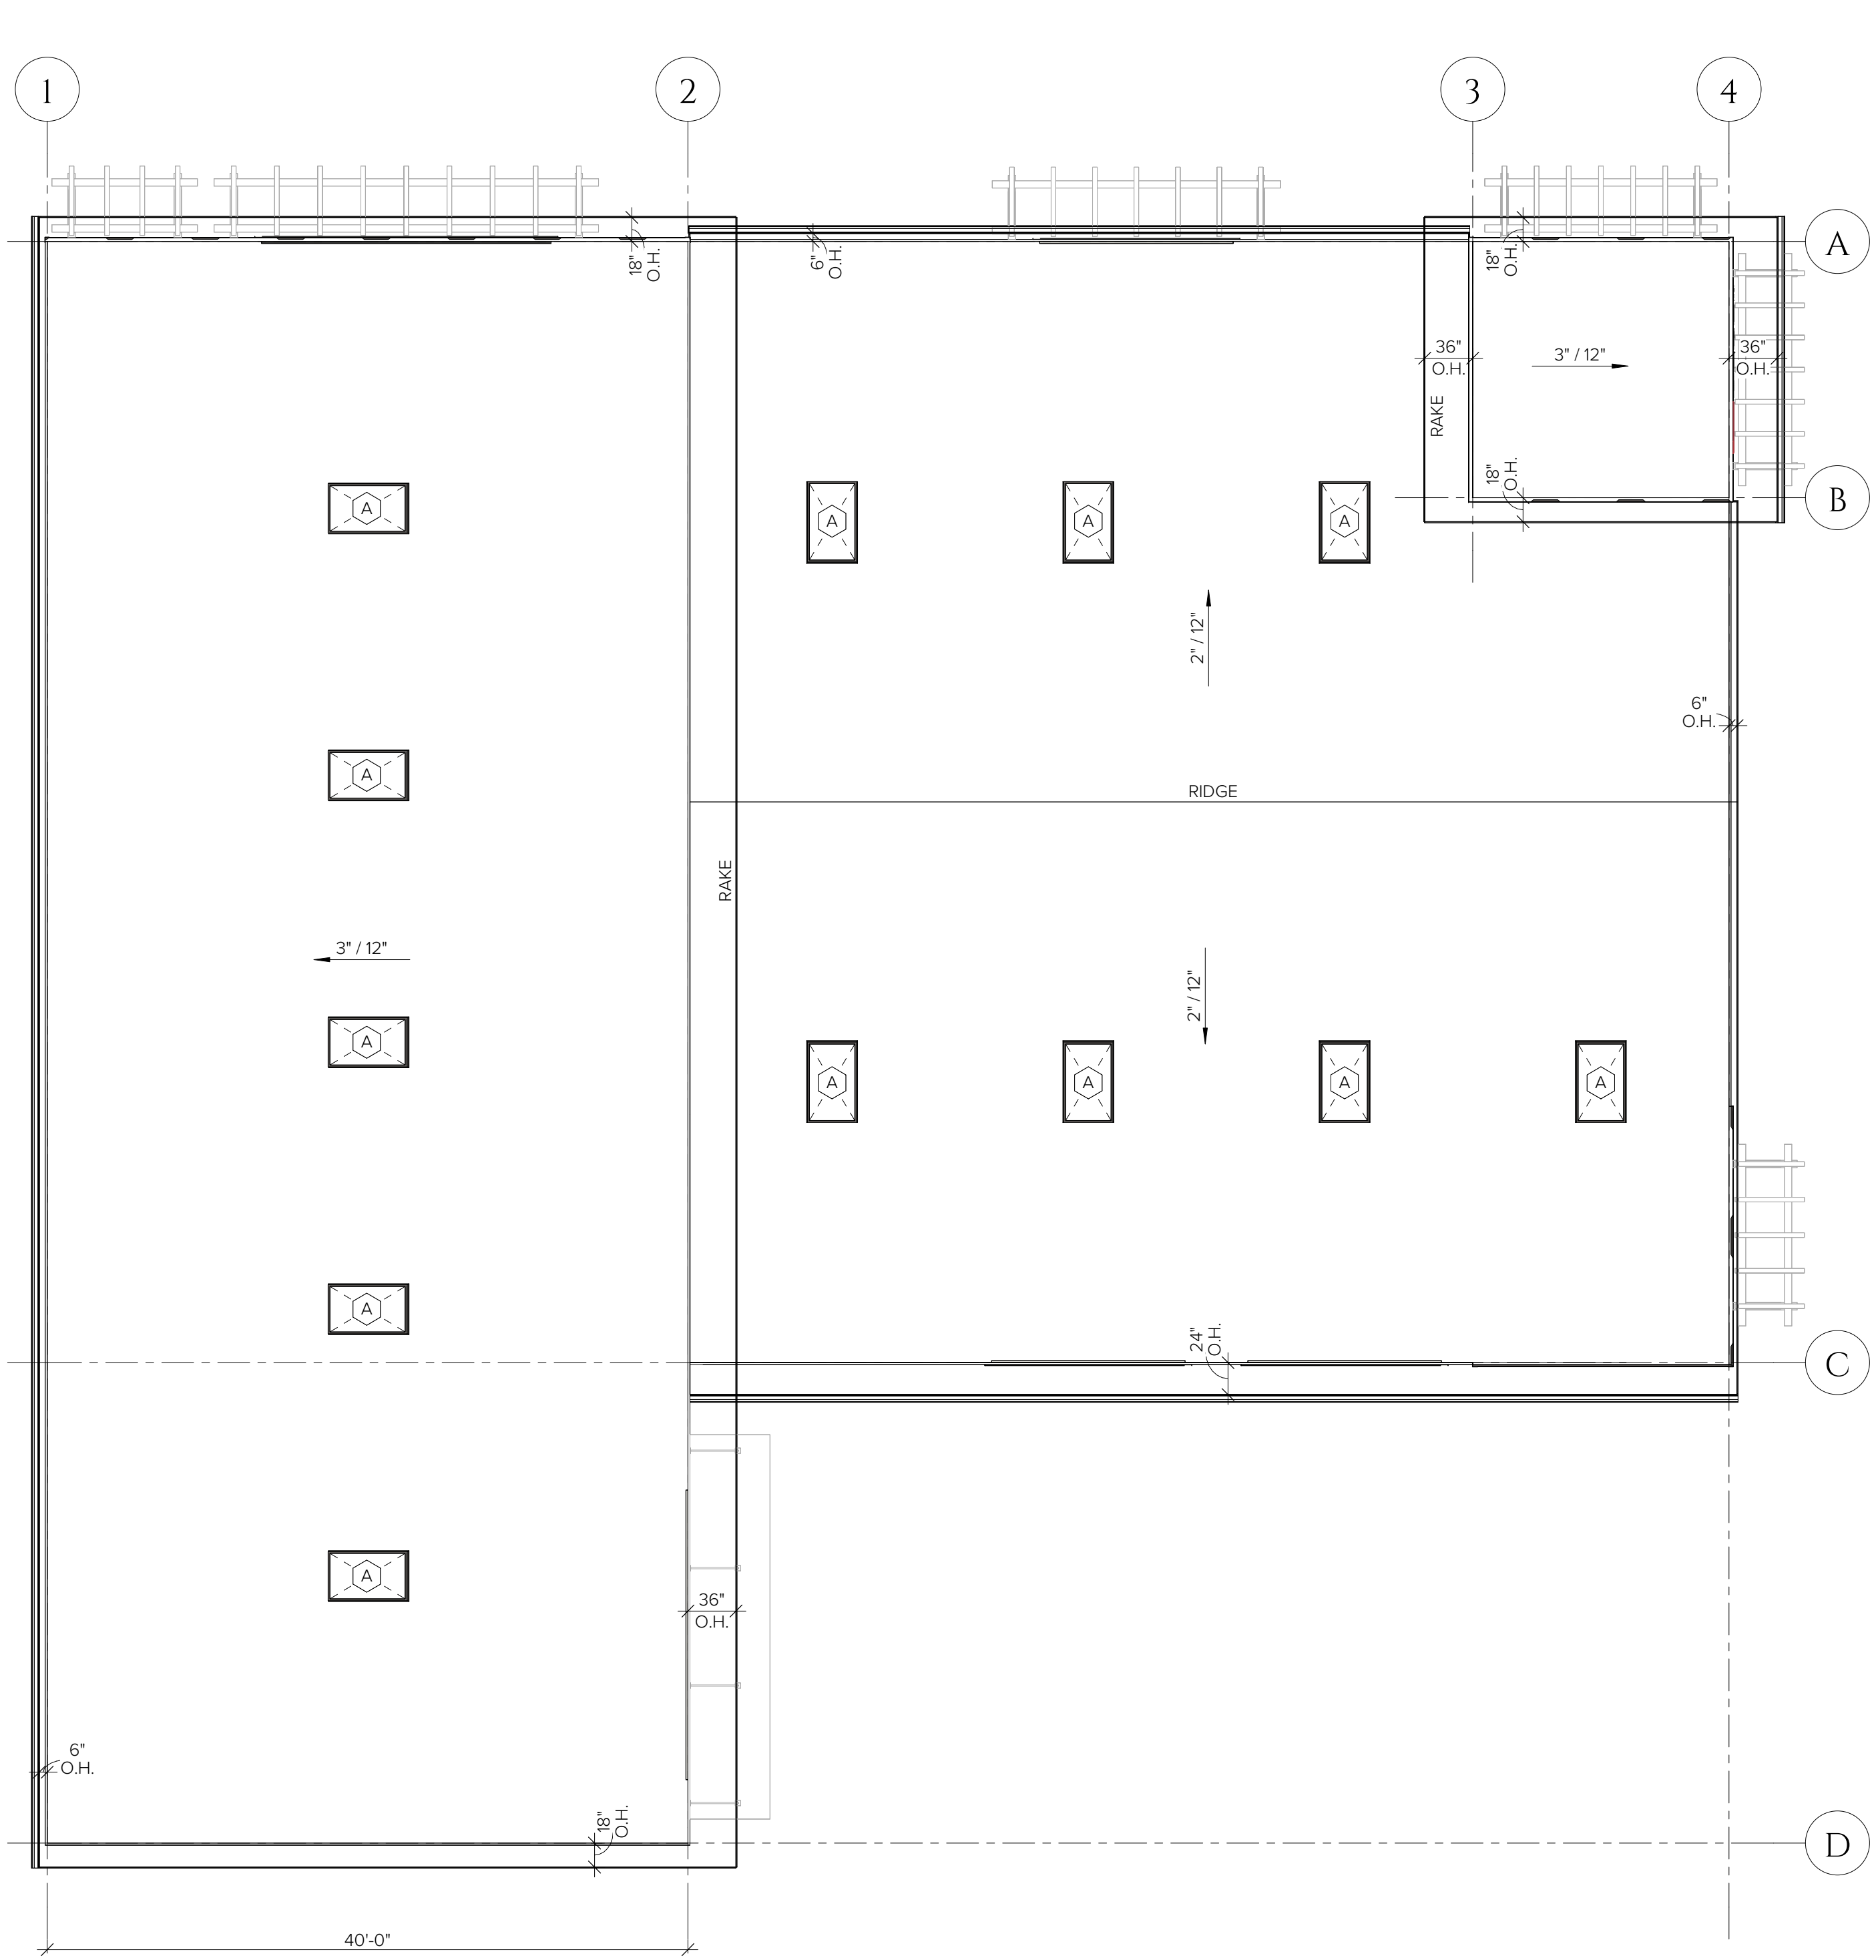

2 | ROOF PLAN
SCALE: 1/8" = 1'-0"

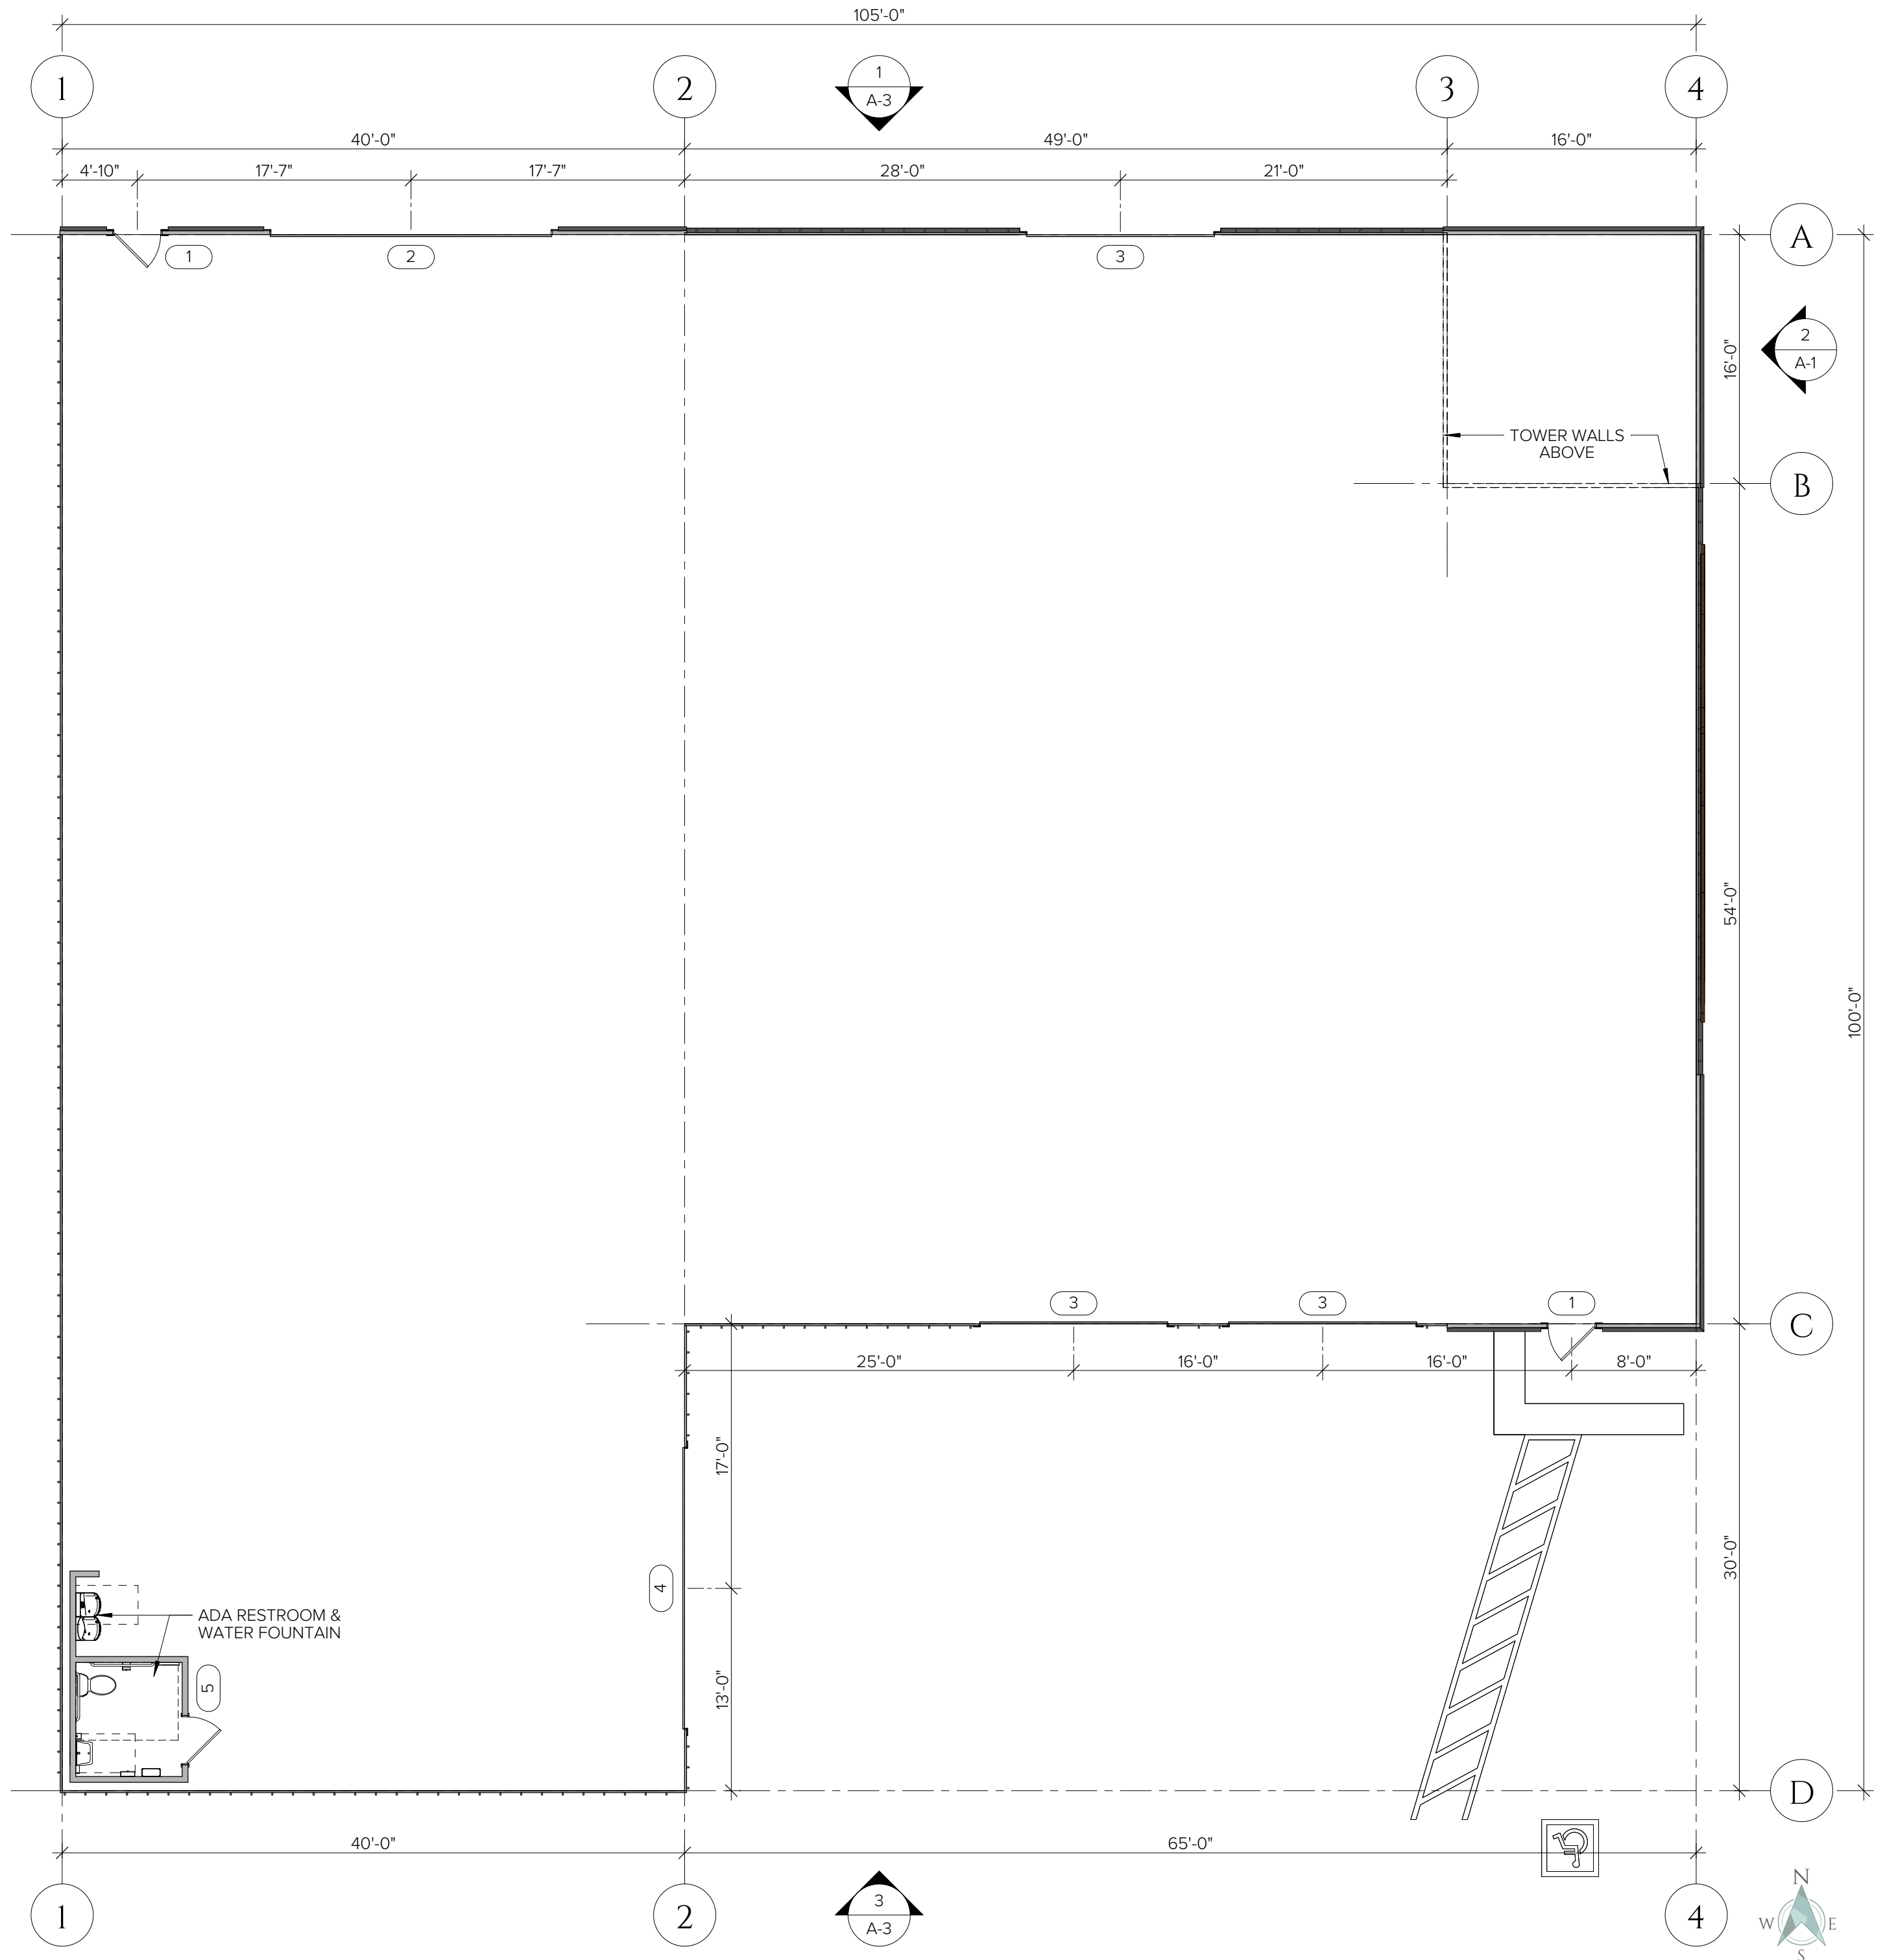

1 | FLOOR PLAN
SCALE: 1/8" = 1'-0"

WINDOW SCHEDULE					
MARK	QTY	WIDTH	HEIGHT	OPERATION	COMMENTS
A	12	3'-0"	5'-0"	SKYLIGHT	

DOOR SCHEDULE					
TYPE	QTY	WIDTH	HEIGHT	DESCRIPTION	COMMENTS
1	2	3'-0"	6'-8"	METAL DOOR	EXTERIOR
2	1	18'-0"	12'-0"	ROLL-UP METAL DOOR	
3	3	12'-0"	10'-0"	ROLL-UP METAL DOOR	
4	1	18'-0"	14'-6"	ROLL-UP METAL DOOR	
5	1	3'-0"	6'-8"	FLAT PANEL FIBERGLASS	INTERIOR

REVISIONS


#	DATE	DESCRIPTION
1	3.31.2025	DESIGN REVIEW COMMENTS

SHEET DATE: 3.31.2025
DRAWN BY: CAT ORY


SHEET NO.

A-3


ACGC KOSTER SHOP

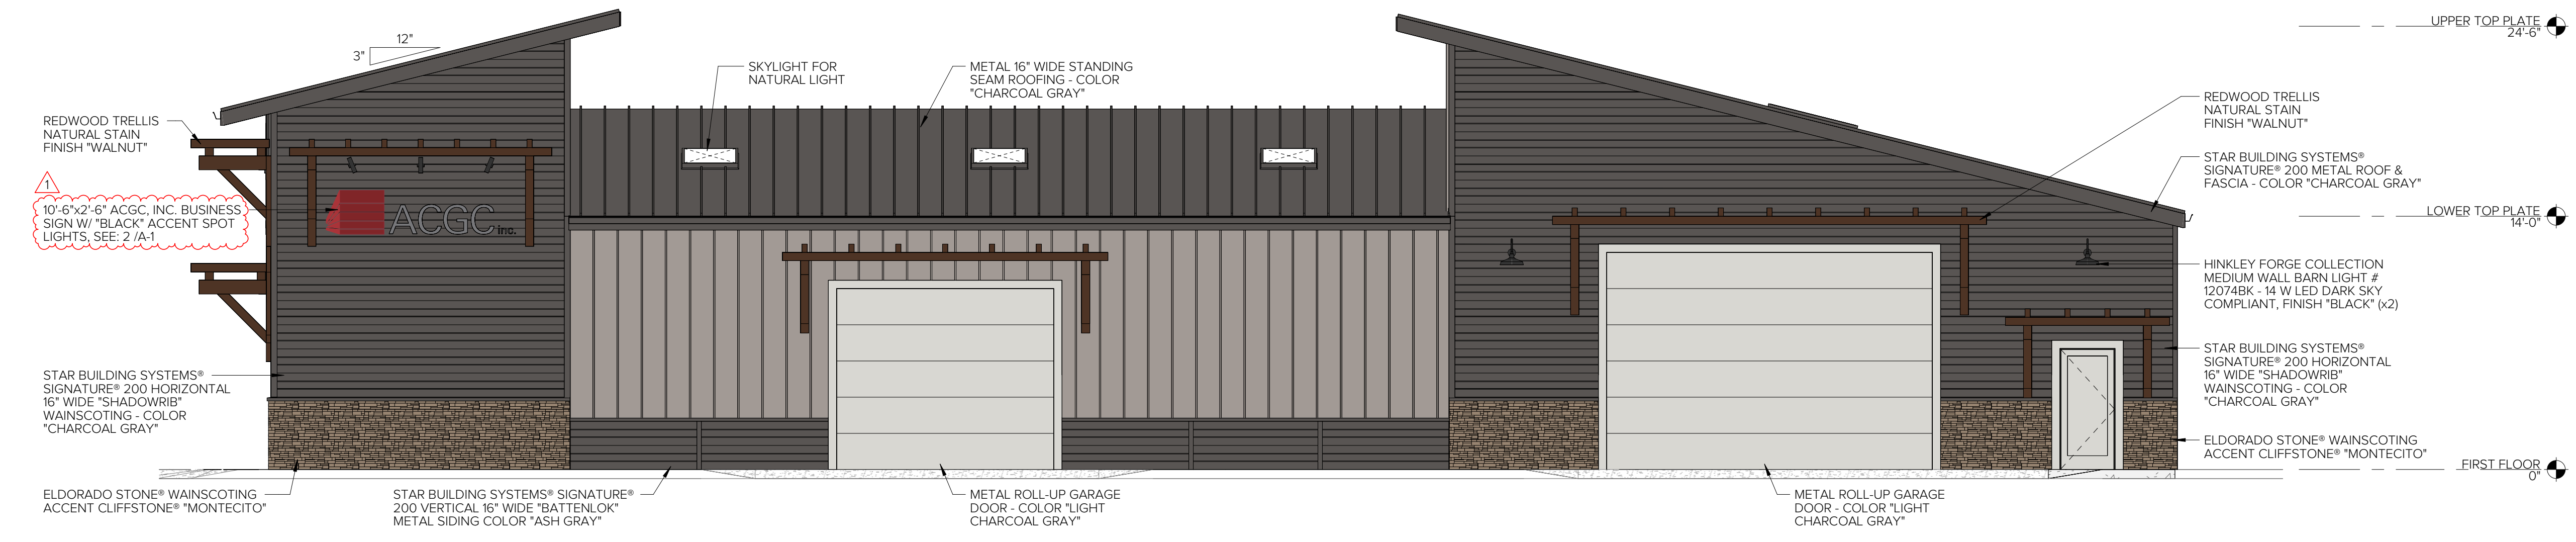

1 | NORTH ELEVATION (W. 15TH ST.)

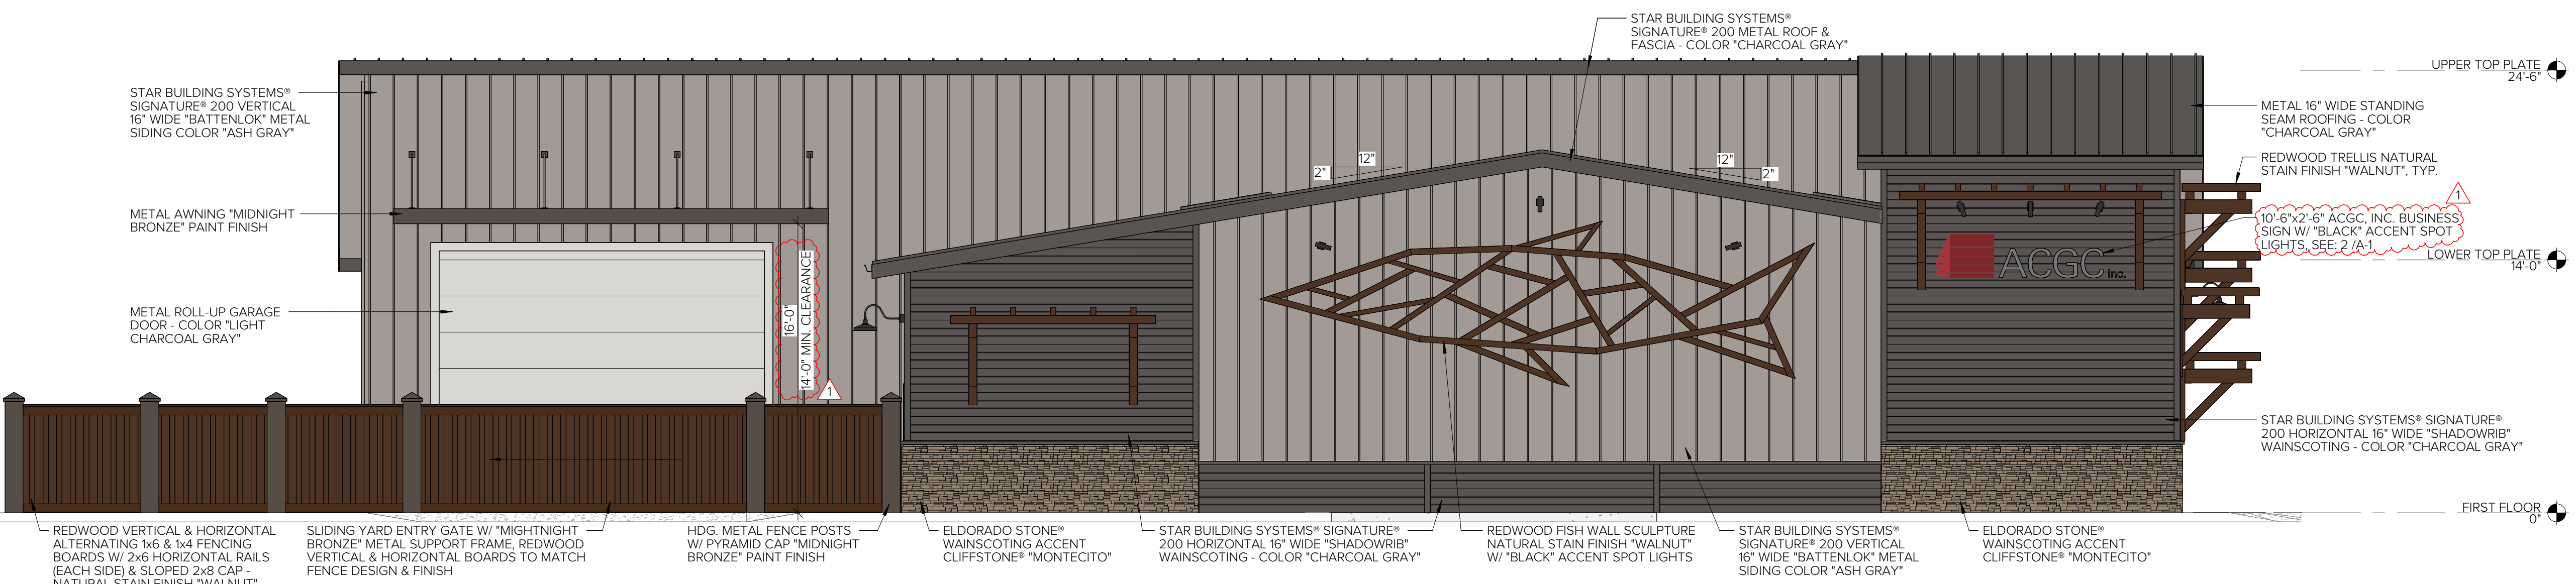

2 | EAST ELEVATION (KOSTER ST.)

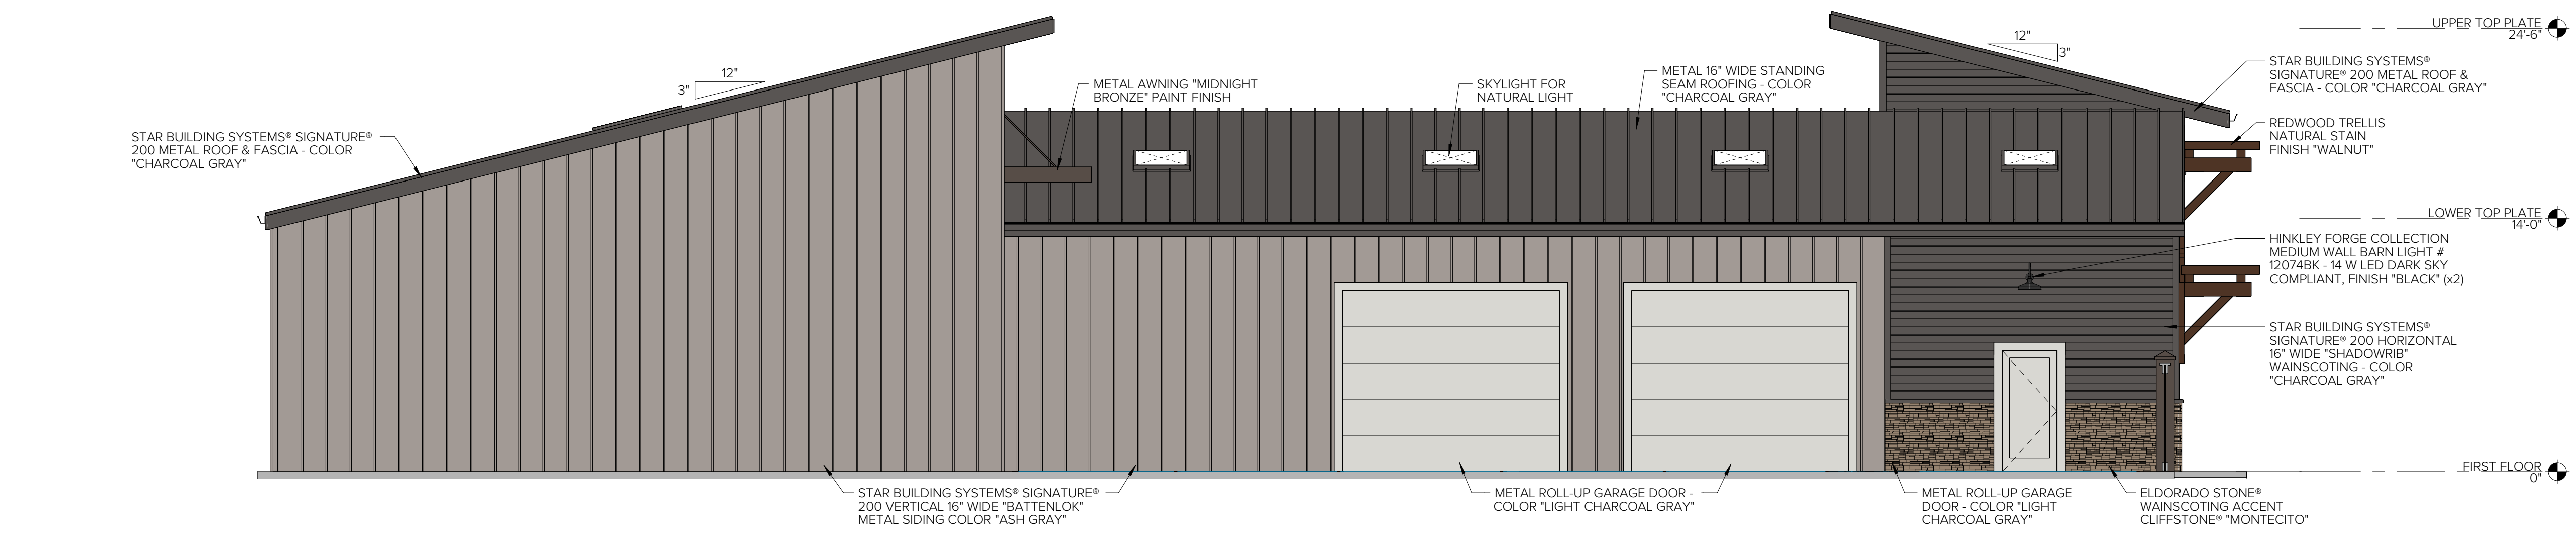

3 | SOUTH ELEVATION (SHOP YARD)



ADAMS COMMERCIAL GENERAL CONTRACTING

REDWOOD TRELLIS
ACCENTS & FENCING
NATURAL STAIN FINISH
"WALNUT"

STAR BUILDING
SYSTEMS®
SIGNATURE® 200
METAL SIDING MAIN
BODY COLOR "ASH GRAY"




HINKLEY
FORGE COLLECTION
MEDIUM WALL
BARN LIGHT
12074BK • 14 W LED
DARK SKY COMPLIANT
FINISH "BLACK"




ELDORADO STONE®
WAINSCOTING ACCENT
CLIFFSTONE®
"MONTECITO"

STAR BUILDING
SYSTEMS®
SIGNATURE® 200
METAL ROOF, FASCIA, &
ACCENT SIDING COLOR
"CHARCOAL GRAY"

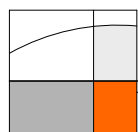

EXTERIOR MATERIAL & LIGHTING COLOR PALLETE

ACGC INC. - KOSTER AVE. SHOP BUILDING


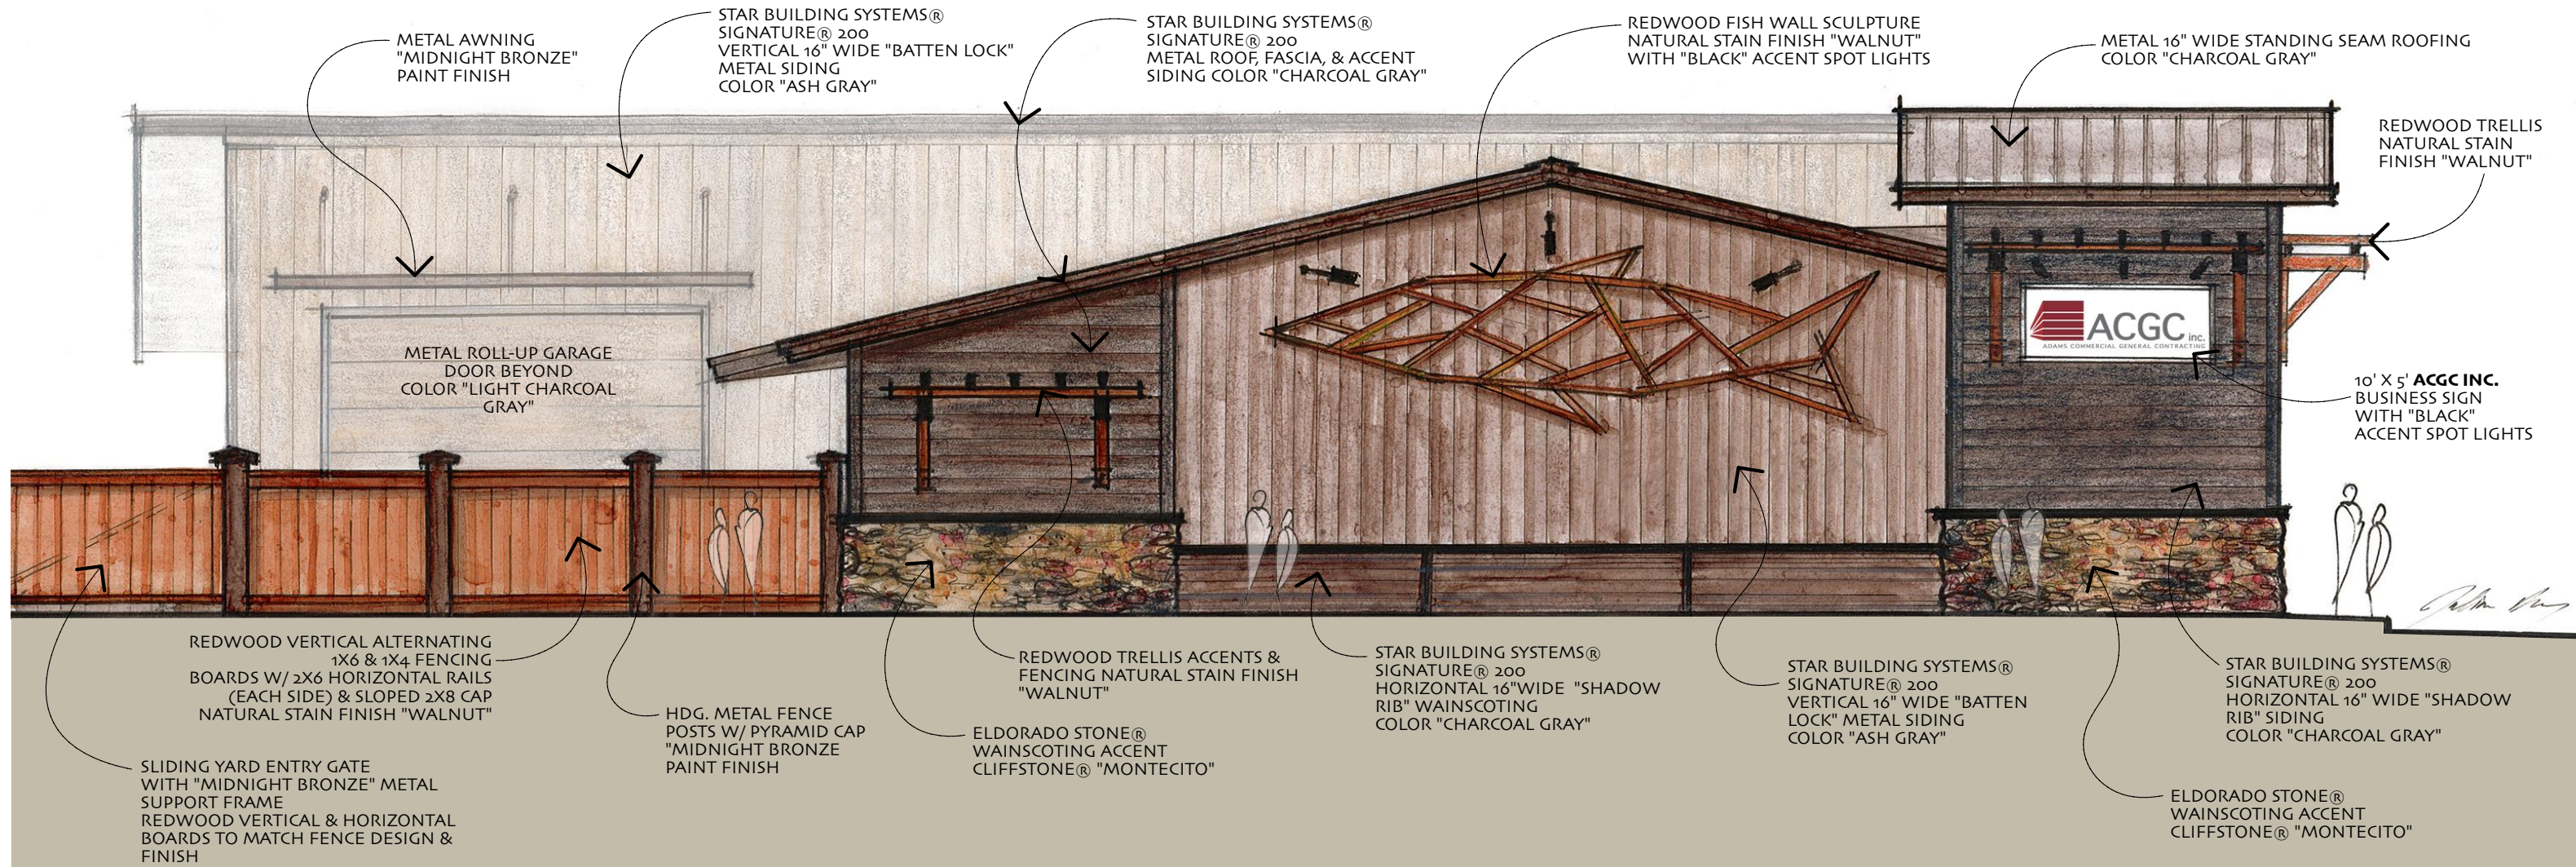


EAST ELEVATION - COLORS & MATERIALS

ACGC INC. - KOSTER AVE. SHOP BUILDING

N.T.S

1.27.25

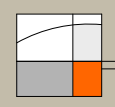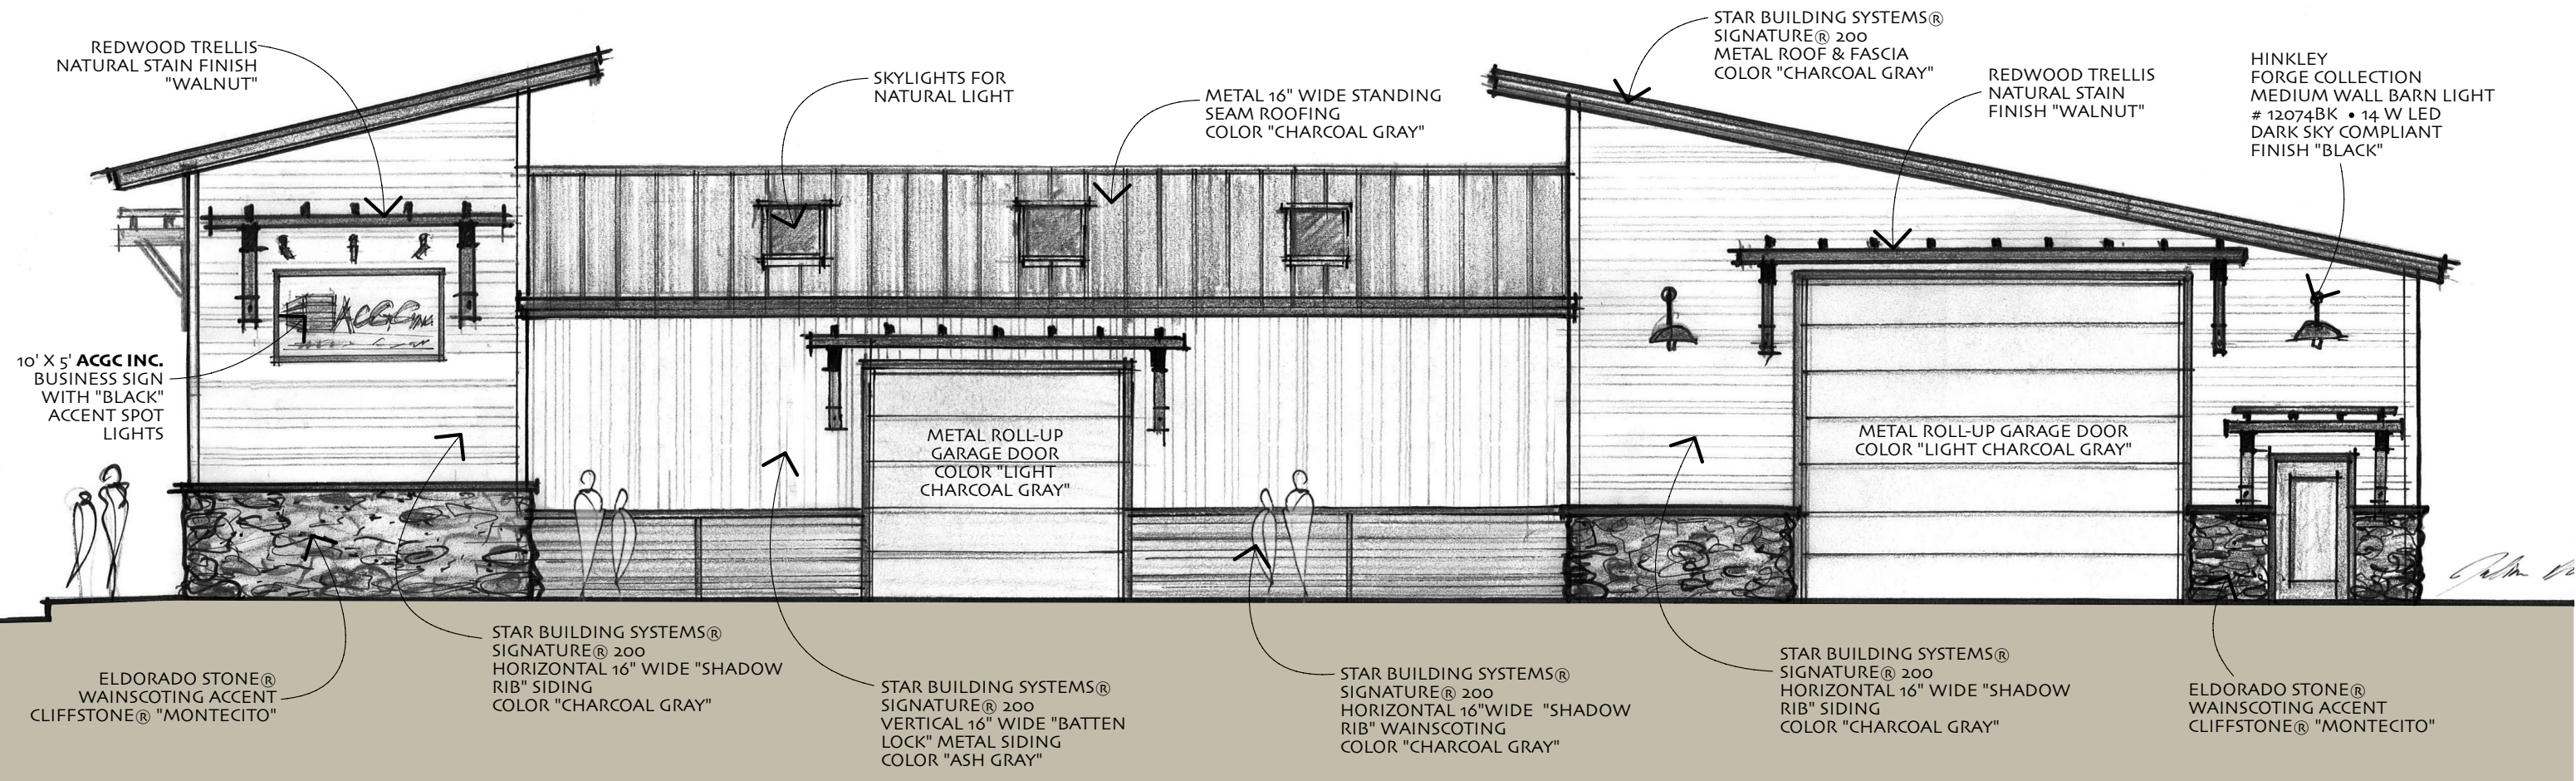

NORTH ELEVATION - COLORS & MATERIALS
 ACGC INC. - KOSTER AVE. SHOP BUILDING

N.T.S
 1.27.25